

Engineering Report

115840
ORIGINAL
(RED)

**REMEDIAL CLEANUP
TREATABILITY STUDY
MILLCREEK SUPERFUND SITE
ERIE, PENNSYLVANIA
VOLUME 2: APPENDICES**

**U.S. Army Corps of Engineers
Omaha District**

August 1989

Project: 0285-23-1

**MALCOLM
PIRNIE**

ENVIRONMENTAL ENGINEERS, SCIENTISTS & PLANNERS

AR001686

ORIGINAL
(RED)

APPENDIX A
SOIL BORING LOGS

**MALCOLM
PIRNIE**

Field Borehole Log

CLIENT U.S. Army Corps of Engineers JOB NO. _____ HOLE NO. SB-2 SHEET NO. _____ OF _____
 PROJECT Remedial Cleanup Treatability Study WEATHER Sunny INSPECTOR T. Murtagh
 SITE Millcreek Superfund Site TEMP. 60° °F STARTED 9:40 .M. 5/10 1988
 LOCATION Erie PA D.P. _____ ° FINISHED 10:30 .M. _____ 19____
 CONTRACTOR Pennsylvania Drilling ELEVATIONS: DATUM _____
 METHOD OF BORING: SOIL 4 1/4" I.D. Auger + 2" split spoon CASING DIAM. _____
 ROCK _____ GROUND SURFACE _____
 CORE DIAM. _____ WATER LEVELS _____

REMARKS:

Augers = 10
 Split Spoons = 6

LOG	DESCRIPTION: COLOR; CONSISTENCY DENSITY; TEXTURE; STRUCTURE; SHAPE AND SURFACE CONDITION OF GRAINS; ODOR; ETC.	ELEV. DEPTH	SAMPLE				BLOWS PER 6 INCH	NOTES: BORING; TESTING AND SAMPLING PROCEDURES; WATER LOSS AND GAIN; DRILLING AND TESTING EQUIPMENT; ETC.
			USCS	NO.	SIZE (IN.)	RETD. (IN.)		
	DK Brn Lse topsoil						15	HNU = 0 PPM spoon
	Rust F. SNO. w. srt	1	FL	1		12"	20	
	1H Rubble, Pbls, Slag						10	
	Dry	2					7	
	Lt. grey - Brn broken						5	HNU = 1-2 PPM spoon
	brick silt-SNO sized	3	FL	2		8"	55	
	cinders dry						47	
		4					96	
	Same AS Above						22	
		5	FL	3		8"	60	Hard Drilling
							13	
		6					14	
								Auger refusal
								Move r/a 5'
		6					5	
	Blk + Orange F. SNO						5	HNU = ~1 PPM is section
	(foundry) Lse Dry	7	FL	4		18"	6	of spoon
	Few solid chunks of						10	
	foundry SNO	8					12	
	Same AS Above						3	
	moist @ 10'	9	FL	5		18"	5	
							6	
		10	▽				6	
	Blk F. SNO, 1H Orn SNO							
	~11" Blk silt grading	11	OL	6		8"		
NAT	to dry grn Cl + silt w/		CL					
	1H - NO	12						

11001689

~~ORIGINAL~~
(RED)

[illegible]

Field Borehole Log

CLIENT U.S. Army Corps of Engineers JOB NO. _____ HOLE NO. SB-4 SHEET NO. _____ OF _____
PROJECT Remedial Cleanup Treatability Study WEATHER clearing / Wind INSPECTOR T. M. Trough
SITE Mills Creek Superfund Site TEMP. _____ °F STARTED 3:30 M. 5/9 19 88
LOCATION Erie PA DIP _____ ° FINISHED 4:20 M. _____ 19 _____
CONTRACTOR Pennsylvania Drilling ELEVATIONS: DATUM _____
METHOD OF SOIL 4 1/4 ID Auger + 2" Split Spoon CASING DIAM. _____
BORING: ROCK _____ GROUND SURFACE _____
CORE DIAM. _____ WATER LEVELS _____

REMARKS:

REMARKS:
Answers = 12

split spoons = 7

[illegible]

ORIGINAL
(RED)

LOG	DESCRIPTION: COLOR; CONSISTENCY DENSITY; TEXTURE; STRUCTURE; SHAPE AND SURFACE CONDITION OF GRAINS; ODOR; ETC.	ELEV. = DEPTH	SAMPLE				BLOWS PER 6 INCH	NOTES: BORING; TESTING AND SAMPLING PROCEDURES; WATER LOSS AND GAIN; DRILLING AND TESTING EQUIPMENT; ETC.
			LISC'S	NO.	SIZE (IN.)	RETD. (IN.)		
	BK F.SND pieces white brick Lse Dry	1	FL	1		17"	4 36 24 18	
	BK F.SND Tan + Rust Lse Dry	2	FL	2		24"	7 3 4 5	
		3						
		4						
	Tan + BK Lse F.SND Foundry Sand w set Dry	5	FL	3		20'	2 2 4 6	
	Same as Above	6	FL	4		18"	2 1 1 1	
		7						
		8						
	BK sft slt w/reworked Native slit + F.SND w/cl mud - wet	9	FL	5		8"	2 1 1 1	
	Nat Orange Brn F.SND Slit lit C.SND wet	10	ML	6		12"	8 13 12 9	

Ch.
(REU)

REMARKS:
Augers = 15'
Split spoons = 11

[illegible]

~~TOP SECRET~~

~~ORIGINAL~~
(RED)

[illegible]

Field Borehole Log

CLIENT U.S. Army Corps of Engineers JOB NO. _____ HOLE NO. SB-6 SHEET NO. _____ OF _____
PROJECT Remedial Cleanup Treatability Study WEATHER Sunny INSPECTOR T. Marten
SITE Millcreek Superfund Site TEMP. 60° °F STARTED 10:50 A.M. 5/11 1988
LOCATION Erie PA DIP _____ ° FINISHED 11:50 A.M. _____ 19____
CONTRACTOR Pennsylvania Drilling ELEVATIONS: DATUM _____
METHOD SOIL 4 1/4" ID Auger + 2" SPIST CASING DIAM. _____
OF _____
BORING: ROCK _____ GROUND SURFACE _____
CORE DIAM. _____ WATER LEVELS _____

REMARKS:

Augers = 10'
Split Spoons = 6

[illegible]

Field Borehole Log

CLIENT U.S. Army Corps of Engineers JOB NO. _____ HOLE NO. SB-8 SHEET NO. _____ OF _____
PROJECT Remedial Cleanup Treatability Study WEATHER Sunny INSPECTOR T. Murtaugh
SITE Millcreek Superfund Site TEMP. _____ °F STARTED 3:50 P.M. 5/11 1988
LOCATION Erie PA DIP _____ ° FINISHED 4:50 P.M. _____ 19_____
CONTRACTOR Pennsylvania Drilling ELEVATIONS: DATUM _____
METHOD OF SOIL 4 1/4 ID Auger + 2" Split Spoon CASING DIAM. _____
BORING: ROCK _____ GROUND SURFACE _____
CORE DIAM. _____ WATER LEVELS _____

REMARKS:

Angers = 10
Split Spoon = 7

[illegible]

~~ORIGINAL~~
~~(RED)~~

[illegible]

Field Borehole Log

CLIENT U. S. Army Corps of Engineers JOB NO. _____ HOLE NO. SB-10 SHEET NO. _____ OF _____
PROJECT Remedial Cleanup Treatability Study WEATHER Partly Sunny INSPECTOR T. M. Murtough
SITE Millcreek Superfund Site TEMP. 60 °F STARTED 8:22 A.M. 5/11 1988
LOCATION Erie PA DIP _____ ° FINISHED 10:00 A.M. _____ 19____
CONTRACTOR Pennsylvania Drilling ELEVATIONS: DATUM _____
METHOD SOIL 4 1/4 ID Auger + 2" SPIIT SPACASING DIAM.
OF
BORING: ROCK _____ GROUND SURFACE _____
CORE DIAM. _____ WATER LEVELS _____

REMARKS:

Angers = 12
split spoons = 9

[illegible]

ORIGINAL
(RED)

[illegible]

Field Borehole Log

REMARKS:

[illegible]

ORIGINAL
(RED)

44-38861-702

**MALCOLM
PIRNIE**

Field Borehole Log

CLIENT U.S. Army Corps of Engineers JOB NO. _____ HOLE NO. SB-14 SHEET NO. _____ OF _____
 PROJECT Remedial Cleanup Treatability Study WEATHER _____ INSPECTOR T. Murtough
 SITE Mills Creek Superfund Site TEMP. _____ °F STARTED 9:07 .M. 5/4 1982
 LOCATION Erie PA DIP _____ ° FINISHED 10:20 .M. _____ 19____
 CONTRACTOR Pennsylvania Drilling ELEVATIONS: DATUM _____
 METHOD SOIL 4 1/4" ID Auger + 2" Split Spoon CASING DIAM. _____
 OF _____
 BORING: ROCK _____ GROUND SURFACE _____
 CORE DIAM. _____ WATER LEVELS _____

REMARKS:

Augers =
Split Spoons =

LOG	DESCRIPTION: COLOR; CONSISTENCY DENSITY; TEXTURE; STRUCTURE; SHAPE AND SURFACE CONDITION OF GRAINS; ODOR; ETC.	ELEV. DEPTH	SAMPLE				BLOWS PER 6 INCH	NOTES: BORING; TESTING AND SAMPLING PROCEDURES; WATER LOSS AND GAIN; DRILLING AND TESTING EQUIPMENT; ETC.
			USCS	NO.	SIZE (IN.)	RETD. (IN.)		
	Blk, Lse, F. SND 1+1 Rubble, Dry	1	Fill	1	24"		4 13	
	Blk, Lse, F. SND 1+1 Rubble Dry wet @ Tip Rust colored SND in tip Poor Recovery	2 3 4	Fill	2	23"			HNU = 1-2 PPM in Aug + cuttings
	Grey Hard cinders/slag DK Rn - Rust F. SND	5	Fill	3	4"			HNU = 10 PPM + 30 PPM in sections of Spoon Tar Odor
	Blk - Rust F. SND wet Oily @ 7.5' NAT soil Horizon, Grn slit W/CL + F SND	6 7 8		4	15"			Rust F. SND + Plastic Around Aug HNU = 7 PPM in spoon tar or Creasote like ODOR
NAT	//////							
	Blk F. SND, Roofing shingles, weathered Fire brick in tip	2 3		5			4 50/5	Move Location 4' West HNU = 2 PPM Augers Hard Augering 3-4'
	Blk - Rust F. SND slit, DK grey C. SND wet @ 4.5'	4 5 6	∇	6				HNU = 2 PPM in saturation section of spoon 30 PPM in vaclose zone just above vaclose zone

AR 001703

ORIGINAL
(RED)

[illegible]

Field Borehole Log

CLIENT U. S. Army Corps of Engineers JOB NO. _____ HOLE NO. SD-16 SHEET NO. _____ OF _____
PROJECT Remedial Cleanup Treatability Study WEATHER _____ INSPECTOR T. Murtagh
SITE Millcreek Superfund Site TEMP. _____ °F STARTED 8 25 A.M. 5/6 1984
LOCATION Erie PA DIP _____ ° FINISHED 9 17 A.M. _____ 19____
CONTRACTOR Pennsylvania Drilling ELEVATIONS: DATUM _____
METHOD SOIL 4 1/4 ID Auger + 2" Split Spoon CASING DIAM. _____
OF BORING: ROCK _____ GROUND SURFACE _____
CORE DIAM. _____ WATER LEVELS _____

REMARKS:

Augers = 6'

$$\text{Split Spoons} = 4$$
[illegible]

Field Borehole Log

CLIENT U.S. Army Corps of Engineers JOB NO. _____ HOLE NO. SC-18 SHEET NO. R OF _____
PROJECT Remedial Cleanup Treatability Study WEATHER Sunny + Breezy INSPECTOR T. Murtagh
SITE Millcreek Superfund Site TEMP. _____ ° STARTED 1:45 M. 5/4 19 84
LOCATION Erie PA DIP _____ ° FINISHED 2:40 M. _____ 19 _____
CONTRACTOR Pennsylvania Drilling ELEVATIONS: DATUM _____
METHOD SOIL 4 1/4" ID Auger + 2" SPI + sp CASING DIAM. _____
OF _____
BORING: ROCK _____ GROUND SURFACE _____
_____ WATER LEVELS _____

REMARKS:

Augers = 7'
Split Spoon = 4'

Note: SB-18B 10' south of SB-18A

[illegible]

**MALCOLM
PIRNIE**

Field Borehole Log

CLIENT U. S. Army Corps of Engineers JOB NO. _____ HOLE NO. SB-19 SHEET NO. _____ OF _____
PROJECT Remedial Cleanup Treatability Study WEATHER _____ INSPECTOR T. Murtaugh
SITE Millcreek Superfund Site TEMP. _____ °F STARTED 8:20 A.M. 5/4 1988
LOCATION Erie PA DIP _____ ° FINISHED 8:30 A.M. _____ 19____
CONTRACTOR Pennsylvania Drilling ELEVATIONS: DATUM _____
METHOD OF SOIL 4 1/4 ID Auger + 2" split spoon CASING DIAM. _____
BORING: ROCK _____ GROUND SURFACE _____
CORE DIAM. _____ WATER LEVELS _____

REMARKS:

Angers = 6'
Split spoons = 5

[illegible]

MALCOLM PIRNIE

Field Borehole Log

CLIENT U.S. Army Corps of Engineers JOB NO. _____ HOLE NO. SB-20 SHEET NO. _____ OF _____
 PROJECT Remedial Cleanup Treatability Study WEATHER _____ INSPECTOR T. Murtaugh
 SITE Millcreek Superfund Site TEMP. _____ °F STARTED 3:50 P.M. 5/4 1988
 LOCATION Erie PA DIP _____ ° FINISHED 4:50 P.M. _____ 19____
 CONTRACTOR Pennsylvania Drilling ELEVATIONS: DATUM _____
 METHOD SOIL 4 1/4 ID Auger + 2" Split Spoon CASING DIAM. _____
 OF _____
 BORING: ROCK _____ CORE DIAM. _____ GROUND SURFACE _____
 WATER LEVELS _____

REMARKS:

Augers = 16'

Split Spoons = 7

LOG	DESCRIPTION: COLOR; CONSISTENCY DENSITY; TEXTURE; STRUCTURE; SHAPE AND SURFACE CONDITION OF GRAINS; ODOR; ETC.	ELEV. DEPTH	SAMPLE				BLOWS PER 6 INCH	NOTES: BORING; TESTING AND SAMPLING PROCEDURES; WATER LOSS AND GAIN; DRILLING AND TESTING EQUIPMENT; ETC.
			USCS	NO.	SIZE (IN.)	RETD. (IN.)		
	Brn Fm SNO Sit		Fill				4	
	Brick w/ BIK F SNO	1		1	16"		13	
	Foundry in tip						17	
	Dry	2					16	
	BIK Lse F SNO		Fill				4	Odor From sample
	Dry	3		2	12"		4	
							50/6	
	Wood in tip moist	4						
	No Recovery		Fill				8	
	Rubber Hose + wood	5		3	0		9	
	in tip of spoon						5	
		6					8	
	Poor Recovery wood		Fill				6	
	Plastic, BIK SNO	7		4	6"		24	
	wet @ 8'						50/1	Move boring Location west
		8						
	Poor Recovery		Fill				2	
	Bricks, BIK SNO	5		5	2"		5	
							6	
		6					3	
	Poor Recovery		Fill				3	
	BIK SNO + Brick	7		6	4"		10	
							5	
		8					5	
	BIK Lse SNO Sit wet						1	
	Nat @ 9.5' Brn Fm	9		7	"		1	
	topsoil, Sit Grn F SNO		OL				1	
	Sit	10	SM				1	

AR001710

**MALCOLM
PIRNIE**

Field Borehole Log

ORIGINAL
(RED)

CLIENT U.S. Army Corps of Engineers JOB NO. _____ HOLE NO. SB-21 SHEET NO. _____ OF _____
 PROJECT Remedial Cleanup Treatability Study WEATHER Sunny INSPECTOR T. Mustagh
 SITE Millcreek Superfund Site TEMP. _____ °F STARTED 4:50 P.M. 5/4 1988
 LOCATION Erie PA DIP _____ ° FINISHED 5:35 P.M. _____ 19____
 CONTRACTOR Pennsylvania Drilling ELEVATIONS: DATUM _____
 METHOD SOIL 4 1/4" I.D. Auger + 2" Split Spoon CASING DIAM. _____
 OF _____
 BORING: ROCK _____ CORE DIAM. _____ GROUND SURFACE _____
 WATER LEVELS _____

REMARKS:

Augers = 10'
Split Spoon = 6'

LOG	DESCRIPTION: COLOR; CONSISTENCY DENSITY; TEXTURE; STRUCTURE; SHAPE AND SURFACE CONDITION OF GRAINS; ODOR; ETC.	ELEV. — DEPTH	SAMPLE				BLOWS PER 6 INCH	NOTES: BORING; TESTING AND SAMPLING PROCEDURES; WATER LOSS AND GAIN; DRILLING AND TESTING EQUIPMENT; ETC.
			USCS	NO.	SIZE (IN.)	RETD. (IN.)		
	DK Brn Lse; F.SND						5	HNu = 5 PPM spoon
	Slt, Few Pbls	1	F1	1		18"	17	Bricks in upper Fill
	Dry						11	
							5	
	Poor Recovery	2					3	HNu = 3 PPM spoon
	DK Brn SND	3	F1	2	5"		3	
	White Fire brick						5	
	in tip	4					1	
	Brn Lse SND						2	HNu = 1.2 PPM spoon
		5	▽	3	12"		3	
	@ 5' BIK F SND +						5	
	Slt wet	6					2	
NAT	Tan + Grey Mtl'd V.F. SND	7	SM	4		18"	5	
	+ Slt, moist, roots,						6	
	1/4" cl	8					6	
							10	
								Move 5'
	see above	2					6	Additional samples
		3	F1	5		15"	6	collected
							7	
		4					10	
	see Above		F1				5	
		5	▽	6			8	
							10	
		6					11	
	Native SND + Slt		SM					
	see Above							ARG01711

1944

**MALCOLM
PIRNIE**

Field Borehole Log

ORIGINAL
(RED)

CLIENT U. S. Army Corps of Engineers JOB NO. _____ HOLE NO. SB-23 SHEET NO. 1 OF 2
 PROJECT Remedial Cleanup Treatability Study WEATHER _____ INSPECTOR T. Murtaugh
 SITE Millcreek Superfund Site TEMP. _____ °F STARTED 3:35 .M. 5/2 1988
 LOCATION Erie PA DIP _____ ° FINISHED 5:35 .M. _____ 19____
 CONTRACTOR Pennsylvania Drilling ELEVATIONS: DATUM _____
 METHOD SOIL 4 1/4" ID Auger + 2" split spoon CASING DIAM. _____
 OF BORING: ROCK _____ GROUND SURFACE _____
 CORE DIAM. _____ WATER LEVELS _____

REMARKS:
 Augers = 16'
 Split spoon = 9'

LOG	DESCRIPTION: COLOR; CONSISTENCY DENSITY; TEXTURE; STRUCTURE; SHAPE AND SURFACE CONDITION OF GRAINS; ODOR; ETC.	ELEV. DEPTH	SAMPLE				BLOWS PER GINCH	NOTES: BORING; TESTING AND SAMPLING PROCEDURES; WATER LOSS AND GAIN; DRILLING AND TESTING EQUIPMENT; ETC.
			USCS	NO.	SIZE (IN.)	RETD (IN.)		
	Brn Lse top soil						1	HNU = 5 PPM spoon
	F. SND, slit, yellow	1	Fill	1	13"		6	HNU = 5 PPM in top
	+ red cemented foundry						5	section of split spoon
	snds Dry	2					6	
	Blk F. SND, slit, Lse						1	
	Cinders, slag, yellow	3	Fill	2	24"		3	
	cemented End Dry						3	
		4					3	
	Blk Lse F. SND, slit						2	
	yellow, tan pieces	5	F.	3	14"		2	
	Dry						2	
		6					2	
	Blk Lse F. SND						2	
	slit, Cinders Dry	7	Fill	4	5"		2	
							3	
		8					3	
	Blk Lse F. SND						2	HNU = 5 PPM in spoon
	slit, yellow + white	9	Fill	5	24"		4	
	Pieces brick, moist in						5	
	in tip of spoon	10					7	
	Blk slit + cl Lse						3	HNU = 300 PPM in spoon
	plastic, Red F-M sand	11	Fill	6	12"		5	
	w/ solid pieces of sand						15	
	wet	12	▽				17	
	Blk Lse slit + cl							
	plastic, some red sand	13	Fill	7				
	Lse + solid wet							
		14						

HNU = 300 PPM in spoon
 AR 001713

Field Borehole Log

JOB NO. _____ HOLE NO. SB-23 SHEET NO. 2 OF 2

Tan, BIK, L-se, F, SNO	15	8	10"	1	HNU = ~300 PPM in
1Hl Slt, 1Hl oil sheen				3	spoon
in H ₂ O wet				3	
16				4	
17				2	High HNU levels in
18				2	Fill ~150 PPM
				3	20-50 PPM in Nat.
				3	SNO

**MALCOLM
PIRNIE**

Field Borehole Log

ORIGINAL
(RED)

CLIENT U.S. Army Corps of Engineers JOB NO. _____ HOLE NO. SB-24 SHEET NO. _____ OF _____
 PROJECT Remedial Cleanup Treatability Study WEATHER Partially sunny INSPECTOR J. Mustaugh
 SITE Mills Creek Superfund Site TEMP. _____ °F STARTED 11:20 M. 5/2 1988
 LOCATION Erie PA DIP _____ ° FINISHED 12:30 M. _____ 19____
 CONTRACTOR Pennsylvania Drilling ELEVATIONS: DATUM _____
 METHOD SOIL 4 1/4 ID Auger + 2" Split Spoon CASING DIAM. _____
 OF _____
 BORING: ROCK _____ GROUND SURFACE _____
 CORE DIAM. _____ WATER LEVELS _____

REMARKS:
 Augers =
 Split Spoons =

LOG	DESCRIPTION: COLOR; CONSISTENCY DENSITY; TEXTURE; STRUCTURE; SHAPE AND SURFACE CONDITION OF GRAINS; ODOR; ETC.	ELEV. DEPTH	SAMPLE				BLOWS PER 6 INCH	NOTES: BORING; TESTING AND SAMPLING PROCEDURES; WATER LOSS AND GAIN; DRILLING AND TESTING EQUIPMENT; ETC.
			USCS	NO.	SIZE (IN.)	RETD (IN.)		
FL	Brn. Lse Topsoil SND, Sit, Dry	1	Fill	1	4"		6 16 50/4	HNU = 1PPM spoon 2 Additional samples Collect from Q-2
FL	Brn + Blk Lse F. SND Hl Sit Dry	2 3	Fill	2	17"		6 10 8 10	
FL	Blk Lse F. SND Foundry SND, some solidified SND, cemented Dry	4 5 6		3	18"		3 3 4 3	HNU = ~2 PPM spoon
FL	Blk Lse F. SND w/white brick, some solid chunks of SND	7 8	Fill	4	14"		3 7 6 4	
FL	Brn, White, Blk, Poor sample, SND, Sit, wet	9	Fill	5	3"			Hard Augering
FL	Poor Recovery, SND Brick, Rubber, Plastic Fill wet	10 11 12	Fill	6	3"		38 5 7 9	Rubber & Plastic comes up in Auger flights w/ Blk SND
NAT	Grn. Firm ^{med} F-M SND Sit, Sit Layers, Hl CL Wet	13	SM	7	8"			

AR001745

~~ORIGINAL~~
(RED)

199-7-0

Field Borehole Log

REMARKS:

Aucers = 9

Split Spoons = 9

Attempted SB-26 on 4/28 @ 830
unable to penetrate surface w/ split spoon
return on this date + complete soil boring.

[illegible]

**MALCOLM
PIRNIE**

Field Borehole Log

CLIENT U.S. Army Corps of Engineers JOB NO. _____ HOLE NO. SB-27 SHEET NO. _____ OF _____
PROJECT Remedial Cleanup Treatability Study WEATHER Cloudy/Drizzle INSPECTOR T. Murtaugh
SITE Millcreek Superfund Site TEMP. 50 °F STARTED 2:00 P.M. 4/27 1988
LOCATION Erie PA DIP _____ FINISHED 5:00 P.M. _____ 19____
CONTRACTOR Pennsylvania Drilling ELEVATIONS: DATUM _____
METHOD OF SOIL 4 1/4 ID Auger + 2" Split Spoon CASING DIAM. _____
BORING: ROCK _____ GROUND SURFACE _____
CORE DIAM. _____ WATER LEVELS _____

REMARKS:

REMARKS.
Augers = 8'

Split Spoons = 6

Too many landfilled Bricks to collect Shelby take sample from this Area

[illegible]

Field Borehole Log

REMARKS:

Aug: 4'
cf: 2 lessons = 2

[illegible]

ORIGINAL
(RED)

Augers = 2
Split Spoons = 4

[illegible]

Field Borehole Log

CLIENT U. S. Army Corps of Engineers JOB NO. _____ HOLE NO. SB-30 SHEET NO. _____ OF _____
PROJECT Remedial Cleanup Feasibility Study WEATHER overcast/Drizzle INSPECTOR T. Murtaugh
SITE Millcreek Superfund Site TEMP. _____ °F STARTED 9¹⁰ .M. 4/28 1988
LOCATION Erie PA DIP _____ ° FINISHED 10²⁴ .M. 4/28 1988
CONTRACTOR Pennsylvania Drilling ELEVATIONS: DATUM _____
METHOD SOIL 4 1/4 ID Auger + 2" Split Sp CASING DIAM. _____
OF _____
BORING: ROCK _____ GROUND SURFACE _____
CORE DIAM. _____ WATER LEVELS _____

REMARKS:
Augers = 6
split Spoons = 5

[illegible]

ORIGINAL
(RED)

REMARKS:
Augers = 10
split spoons = 7

[illegible]

Field Borehole Log

CLIENT U.S. Army Corps of Engineers JOB NO. _____ HOLE NO. SB-33 SHEET NO. _____ OF _____
PROJECT Remedial Cleanup Treatability Study WEATHER _____ INSPECTOR T. Martagh
SITE Millcreek Superfund Site TEMP. _____ °F. STARTED 300 M. 4/28 1988
LOCATION Erie PA DIP _____ ° FINISHED _____ M. _____ 19____
CONTRACTOR Pennsylvania Drilling ELEVATIONS: DATUM _____
METHOD SOIL 4 1/4 ID Auger + 2" Split Spoon CASING DIAM. _____
OF _____
BORING: ROCK _____ GROUND SURFACE _____
CORE DIAM. _____ WATER LEVELS _____

REMARKS:

Angers = 11
Split Spoons = 5

LOG	DESCRIPTION: COLOR; CONSISTENCY DENSITY; TEXTURE; STRUCTURE; SHAPE AND SURFACE CONDITION OF GRAINS; ODOR; ETC.	ELEV. - DEPTH	SAMPLE				BLOWS PER 6 INCH	NOTES: BORING; TESTING AND SAMPLING PROCEDURES; WATER LOSS AND GAIN; DRILLING AND TESTING EQUIPMENT; ETC.
			LSCS	NO.	SIZE (IN.)	RETD (IN.)		
FL	Brn Lse top soil	1	Fill	1	24"	2	HNU = 60 PPM in borehole	
	Slt, SND, Brick in					7	HNU = 12 PPM in spoon	
	tip of spoon Dry					4		
						1		
FL	Blk Lse SND, Slt	2	Fill	2	24"	3	1 PPM in Augers	
	w/ Hd. white + Grn Resin					16		
	or slag in tip					15		
						16		
		3		5"	7	Spoon Refusal @ 5'		
					50/6	Auger refusal		
	Move 10' S., rig unable	5						
	to Auger past 4'							
	Move Again, 10' S.							
FL	Blk, Lse, SND, wood	6	Fill	4	5"	4		
	moist - wet					3		
						8		
						4		
FL	Poor Sample, wood	8		5	3"	2		
	in spoon					2		
						2		
						2		
		9						
AR001723								

OP-3
(REL)

AR 00 725

Field Borehole Log

CLIENT U. S. Army Corps of Engineers JOB NO. _____ HOLE NO. SB-34 SHEET NO. _____ OF _____
PROJECT Remedial Cleanup Treatability Study WEATHER overcast INSPECTOR T. Murtagh
SITE Millcreek Superfund Site TEMP. _____ °F STARTED 11:40 M. 4/28 1988
LOCATION Erie PA DIP _____ ° FINISHED 2:32 M. _____ 19____
CONTRACTOR Pennsylvania Drilling ELEVATIONS: DATUM _____
METHOD SOIL 4 1/4 ID Auger + 2" SPI + Spoon CASING DIAM. _____
OF _____
BORING: ROCK _____ GROUND SURFACE _____
CORE DIAM. _____ WATER LEVELS _____

REMARKS:

Angers = 10

$$SPI \cdot Spoons = 8$$

Shelby tubes 2' + 5'

[illegible]

ORIGINAL
(RED)

Angers = 41
Split Spoons = 5

[illegible]

Field Borehole Log

REMARKS:

Answers = 41

$$\leq \text{split} \leq \text{poons} = 3$$
[illegible]

Official
(RED)

000728

Field Borehole Log

CLIENT C.O.E.
PROJECT _____
SITE Millcreek
LOCATION Erie PA
CONTRACTOR PA Drilling
METHOD OF BORING: SOIL Auger & split spoons
ROCK _____

JOB NO. _____ HOLE NO. ^{SB} 38 SHEET NO. _____ OF _____
 WEATHER Overcast INSPECTOR T. M. Murrain
 TEMP. _____ °F STARTED 10:50 A.M. 5/5 1938
 D.P. _____ ° FINISHED 11:25 A.M. _____ 19____
 ELEVATIONS: DATUM _____
 CASING DIAM. _____
 _____ GROUND SURFACE _____
 CORE DIAM. _____ WATER LEVELS _____

REMARKS:

Augers = 8'
Spoons = 5

[illegible]

Field Borehole Log

CLIENT COE
PROJECT _____
SITE Millcreek
LOCATION Eric PA
CONTRACTOR PA Drilling
METHOD OF BORING: SOIL Shelby Tube
ROCK _____

shelby @

JOB NO. _____ HOLE NO. SB-38 SHEET NO. _____ OF _____

WEATHER Foggy + Break INSPECTOR T. Murtang

TEMP. _____ °F STARTED 7:45 A.M. 5/6 1958

DIP. _____ ° FINISHED 8:22 A.M. _____ 19

ELEVATIONS: DATUM _____

CASING DIAM. _____

_____ GROUND SURFACE

CORE DIAM. _____

_____ WATER LEVELS _____

REMARKS:

[illegible]

ORIGINAL
(RED)

[illegible]

Field Borehole Log

REMARKS:

Angers = 6
Split Spoons = 4

[illegible]

AR001732

**MALCOLM
PIRNIE**

Field Borehole Log

ORIGINAL
(RED)

CLIENT U.S. Army Corps of Engineers JOB NO. _____ HOLE NO. SR-41 SHEET NO. _____ OF _____
 PROJECT Remedial Cleanup Treatability Study WEATHER _____ INSPECTOR T. Murtaugh
 SITE Millcreek Superfund Site TEMP. _____ °F STARTED 2:35 P.M. 5/5 1988
 LOCATION Erie PA DIP _____ ° FINISHED 4:10 P.M. _____ 19____
 CONTRACTOR Pennsylvania Drilling ELEVATIONS: DATUM _____
 METHOD OF BORING: SOIL 4 1/4 ID Auger + 2" Split Spoon CASING DIAM. _____
 ROCK _____ GROUND SURFACE _____
 CORE DIAM. _____ WATER LEVELS _____

REMARKS:
 Augers = 12
 Split Spoon = 7

LOG	DESCRIPTION: COLOR; CONSISTENCY DENSITY; TEXTURE; STRUCTURE; SHAPE AND SURFACE CONDITION OF GRAINS; ODOR; ETC.	ELEV. DEPTH	SAMPLE				BLOWS PER 6 INCH	NOTES: BORING; TESTING AND SAMPLING PROCEDURES; WATER LOSS AND GAIN; DRILLING AND TESTING EQUIPMENT; ETC.
			USCS	NO.	SIZE (IN.)	RETD. (IN.)		
	DK Brn Topsoils Lse						3	HNu = 1 PPM spoon
	SND, SLT, Rubbish,	1	F1	1	14"		8	
	glass, Pieces of Brick						12	
	Dry	2					6	
	DK Brn Lse Rubbish						5	HNu = 5 PPM spoon
	Brick, C. SND sized	3	F1	2	11"		5	
	particals						6	
		4					4	
	BLK Lse F. SND						4	HNu = 2-3 PPM spoon
	white Frm, SLT + SND	5	F1	3	10"		4	
	sized Fill, plastic						3	
	Dry	6					6	
Nat	@ ~ 6.2' Native		OL				8	
	topsoil Horizon DK Brn	7		4	24"		11	
	Lse, moist, @ 6.5'						9	
	Tan mottled Cly, HSLT, moist	8	CL				10	
	Poor Recovery						1	Sample interpreted
	Tan Cly, Sample	9	CL	5	3"		1	to be clay same as
	pulls out of spoon						2	6-8'
							3	
	Grey F-C SND	10	SW				1	Running Sand Flows
	Wet	11		6	22"		1	up, Fine sand on top
							1	Coarse SND on bottom
		12					1	of spoon

AR001733

Field Borehole Log

CLIENT U. S. Army Corps of Engineers JOB NO. _____ HOLE NO. SB-42 SHEET NO. _____ OF _____

PROJECT Remedial Cleanup Feasibility Study WEATHER Drizzle INSPECTOR MurtAugh

SITE Millcreek Superfund Site TEMP. _____ °F STARTED 10:50 A.M. 4/27 1982

LOCATION Erie PA DIP _____ ° FINISHED 11:45 A.M. 4/27 1982

CONTRACTOR Pennsylvania Drilling ELEVATIONS: DATUM _____

METHOD SOIL 4 1/4 ID Auger + 2" SPI + sp CASING DIAM. _____

OF _____

BORING: ROCK _____ GROUND SURFACE _____

CORE DIAM. _____ WATER LEVELS _____

REMARKS:

REMARKS:
Augers = 4
Spoons = 5

[illegible]

MALCOLM
PIRNIE

Field Borehole Log

ORIGINAL
(RED)

CLIENT U.S. Army Corps of Engineers JOB NO. _____ HOLE NO. SB-43 SHEET NO. _____ OF _____
 PROJECT Remedial Cleanup Treatability Study WEATHER Overcast INSPECTOR T. Murtaugh
 SITE Millcreek Superfund Site TEMP. _____ °F STARTED 8:10 A.M. 4/27 1988
 LOCATION Erie PA DIP _____ ° FINISHED 9:15 A.M. _____ 19____
 CONTRACTOR Pennsylvania Drilling ELEVATIONS: DATUM _____
 METHOD SOIL 4 1/4" ID Auger + 2" Split Spoon CASING DIAM. _____
 OF BORING: ROCK _____ GROUND SURFACE _____
 CORE DIAM. _____ WATER LEVELS _____

REMARKS:

Augers = 9'

Split Spoon = 5'

Shelby tube = 5'

LOG	DESCRIPTION: COLOR; CONSISTENCY DENSITY; TEXTURE; STRUCTURE; SHAPE AND SURFACE CONDITION OF GRAINS; ODOR; ETC.	ELEV. DEPTH	SAMPLE				BLOWS PER 6 INCH	NOTES: BORING; TESTING AND SAMPLING PROCEDURES; WATER LOSS AND GAIN; DRILLING AND TESTING EQUIPMENT; ETC.
			USCS	NO.	SIZE (IN.)	RETD (IN.)		
FI	Bcn Lse SAND Topsoil	1	Fill	1	18"		4	
	(S-1.) Blue, white + Red						4	
	SND, Silt (1-2') Red tan-						2	
	Blk F-M. SND Fill, Blk, Dush	2					3	
Wat	F. SND, Dry		ML	2	18"		6	5 PPM in borehole
	2-3' Blk Lse F. SND Dry	3					9	
	Grn - TAN, SIF, Silt						9	Native c 3.3'
	Cl, F. Snd, Dry	4					11	
	Tan w/ 1/4 grn, Med.		SM	3	15"		2	Additional split spoon
	A. SND + Silt moist	5					2	sample collected 5' we
							3	of SB-43
							4	
	Tan - Gry, Med. F. SND	6	SM	4	9"		4	
	Pbls w/ silt wet	7					4	
							4	
							5	
	Move rig ~5' And							
	Sample w/ 5' Shelby	0						
	tube							
	First Attempt bends	1						
	bottom of tube @							
	refusal, cut off	2						
	bottom of tube							Shortened Shelby = 4'3"
								total Length
	Second Attempt -							22" Recov + 21" = 4'3"
	22" Recovery, Remainder							
	of tube filled with							
	Clean Sand + Sealed							

AR001735

Field Borehole Log

REMARKS:
Auaers = 7
split spoons = 5

[illegible]

AR001736

ORIGINAL
(RED)

[illegible]

ORIGINAL
(RED)

LOG	DESCRIPTION: COLOR; CONSISTENCY DENSITY; TEXTURE; STRUCTURE; SHAPE AND SURFACE CONDITION OF GRAINS; ODOR; ETC.	ELEV. - DEPTH	SAMPLE				BLOWS PER 6 INCH	NOTES: BORING; TESTING AND SAMPLING. PROCEDURES; WATER LOSS AND GAIN; DRILLING AND TESTING EQUIPMENT; ETC.	
			USCS	NO.	SIZE (IN.)	RETD. (IN.)			
FL	DK Brn - BIK F. SNO Slt, Few yellow specks Lse, Dry	1'	Fill	1		20"	2 6 9 9	HNU = .5 PPM spoon	
		2							
	FL	DK Brn - BIK Lse, FSM Slt, Few yellow specks Dry	3	Fill	2		14"	4 3 3 5	HNU = .5 PPM spoon No volatiles detected in breathing zone
		4							
FL		Same, with reddish tint, wet @ 5.5'	5	Fill	3		13"	2 3 3 1	HNU = 2 PPM spoon
		6	▽						
	FL	DK Brn - BIK Lse F. SNO Slt, Wet	7		4		17"	2 5 6 6	HNU = .6 spoon
Nat		DK Brn, Fm Slt, CL topsoil horizon @ 7.2'	8	CL					
		Grnish - gry Slt, Slt H/C, H/F F. SNO, tight @ 9.5 Grey C. SNO Ang Cvl, Slt moist	9	ML	5		19"	2 4 10 18	HNU = .2 spoon
		10							

Field Borehole Log

CLIENT U.S. Army Corps of Engineers JOB NO. _____ HOLE NO. SB 46 SHEET NO. 2 OF 2
PROJECT Remedial Cleanup Feasibility Study WEATHER Drizzle INSPECTOR T. Murtagh
SITE Mills Creek Superfund Site TEMP. _____ °F STARTED 1:00 P.M. 4/26 1986
LOCATION Erie PA DIP _____ ° FINISHED 3:00 P.M. _____ 19____
CONTRACTOR Pennsylvania Drilling ELEVATIONS: DATUM _____
METHOD OF BORING: SOIL 4 1/4 ID Auger + 2" Split Spoon CASING DIAM. _____
ROCK _____ GROUND SURFACE _____
CORE DIAM. _____ WATER LEVELS _____

REMARKS: Shelby Tube Location (S) S' North of SB-416

[illegible]

ORIGINAL
(RED)

Note: SB-47 moved NW see updated Survey

~~AR001740~~

MALCOLM PIRNIE

Field Borehole Log

CLIENT U.S. Army Corps of Engineers JOB NO. _____ HOLE NO. SB-48 SHEET NO. _____ OF _____
 PROJECT Remedial Cleanup Treatability Study WEATHER _____ INSPECTOR T. M. Austin
 SITE Millcreek Superfund Site TEMP. _____ °F STARTED 9:40 A.M. 5/3 1988
 LOCATION Erie PA DIP _____ ° FINISHED 11:00 A.M. _____ 19____
 CONTRACTOR Pennsylvania Drilling ELEVATIONS: DATUM _____
 METHOD SOIL 4 1/4 ID Auger + 2" Split Spoon CASING DIAM. _____
 OF _____
 BORING: ROCK _____ CORE DIAM. _____ GROUND SURFACE _____
 WATER LEVELS _____

REMARKS:
 Augers = 12'
 Split Spoons = 7

LOG	DESCRIPTION: COLOR; CONSISTENCY DENSITY; TEXTURE; STRUCTURE; SHAPE AND SURFACE CONDITION OF GRAINS; ODOR; ETC.	ELEV. DEPTH	SAMPLE				BLOWS PER 6 INCH	NOTES: BORING; TESTING AND SAMPLING PROCEDURES; WATER LOSS AND GAIN; DRILLING AND TESTING EQUIPMENT; ETC.
			USCS	NO.	SIZE (IN.)	RETD. (IN.)		
	Brn - Blk Lse, F. SND		Fill				16	HNU = 0 PPM spoon
	Slt, topsoil on surface	1		1	17"		11	
	Dry						5	
		2					6	
	Poor Recovery						4	HNU = 1 PPM spoon
	Blk F. SND + Slt, Frm	3		2	6"		26	
	moist to wet, plastic						50/5	
	cinders in tip	4	▽					Water @ 4' Perched
	Lt Brn - Blk, SND, Slt		Fill				16	HNU = 1 PPM spoon
	Brick L. - moist	5		3	6"		8	
							10	
							9	
	Blk - Brn Lse, F. SND	6	Fill				4	HNU = 0 PPM spoon
	Slt, moist, some	7		4	16"		4	
	chunks of cemented						5	
	SND, zone of white SND	8					7	
	Blk - Lt Reddish Brn		Fill				1	HNU = 12 PPM spoon
	F. SND, mod-w, srt	9		5	19"		1	
	Dry - moist						1	
		10					1	
	Blk F. SND Lse,		Fill				1	HNU = 4 PPM spoon
	11-12' stained Blk	11		6	16"		5	
	oil or tar binding SND						5	
		12	▽				7	
	Blk F. SND (foundry) 12-12.5						2	HNU = 4 PPM spoon
	12.5-13' Wet oily Grl + SND	13		7	20		2	
	shiny						2	
Wat	@ 13' Blk Frm Slt, topsoil		OL				3	
	Horizon stained Blk	14					5	
	@ 13.5 Grn Slt, F. SND + Cl moist		ML					BR001741

ORIGINAL
(RED)

[illegible]

AR001742

**MALCOLM
PIRNIE**

Field Borehole Log

CLIENT U.S. Army Corps of Engineers JOB NO. _____ HOLE NO. SB-50 SHEET NO. _____ OF _____
 PROJECT Remedial Cleanup Treatability Study WEATHER Overcast INSPECTOR T. Murtaugh
 SITE Millers Creek Superfund Site TEMP. _____ °F STARTED 7:40 .M. 4/29 1988
 LOCATION Erie PA DIP _____ ° FINISHED 8:20 .M. _____ 19____
 CONTRACTOR Pennsylvania Drilling ELEVATIONS: DATUM _____
 METHOD SOIL 4 1/4 ID Auger + 2" SPI + Spoon CASING DIAM. _____
 OF BORING: ROCK _____ GROUND SURFACE _____
 CORE DIAM. _____ WATER LEVELS _____

REMARKS:

Augers = 8'
 SPI + Spoons = 6'

LOG	DESCRIPTION: COLOR; CONSISTENCY DENSITY; TEXTURE; STRUCTURE; SHAPE AND SURFACE CONDITION OF GRAINS; ODOR; ETC.	ELEV. DEPTH	SAMPLE				BLOWS PER 6 INCH	NOTES: BORING; TESTING AND SAMPLING PROCEDURES; WATER LOSS AND GAIN; DRILLING AND TESTING EQUIPMENT; ETC.
			USCS	NO.	SIZE (IN.)	RETD. (IN.)		
FL	Brn - DK Brn Lse F.SND, SLT, Cinders Dry	1	Fill	1	22"		2 24 24 10	HNU = 0 Borehole
FL	Brn - BLK Lse SNDy Fill, SLT Dry	2	Fill	2	10"			HNU = 0 Borehole
	No representative Recovery	3		3	2"		1 1 1	
	Moved boring 5' S.W.	4						
FL	DK Brn - BLK Lse F.SND, SLT, Few white specks, Bluish Chunks. Dry	1	Fill	4	20"		4 10 10 10	HNU = 1-2 PPM spoon HNU = ~.5 PPM Borehole
	/ Skipped /	2						
	/ / / / /	3						
FL	Brn Lse SNDy SLT, Fill wood	4	Fill	5			2 3 3 2	Additional 0-2 Spoon collected
	Native Brn, organic SLT moist	5						
NA+		6	OL					ABOUT 743

ORIGINAL
(RED)

~~SECRET~~

Field Borehole Log

REMARKS:

SB-51 Offsite Location @ Baseball Field
Far Western boundary of site

Augers = 0'
SPLT spoons = 3

[illegible]

AROD 1745

OFFICIAL
(RED)

1500-756

ORIGINAL
(RED)

APPENDIX B
MONITORING WELL BORING LOGS

**MALCOLM
PIRNIE**

Field Borehole Log

CLIENT US ARMY COE
PROJECT _____
SITE MILLCREEK
LOCATION EIRE PA
CONTRACTOR PENN. DRILLING
METHOD SOIL 4 1/4" ID AUGER
OF
BORING: ROCK

JOB NO. 0285-23-1 HOLE NO. PW-P SHEET NO. 1 OF 1
 WEATHER RAIN INSPECTOR RHO
 TEMP. 50 °F STARTED 10 45 A.M. 4/29 1961
 DIP • FINISHED 2 30 P.M. 4/29 1961

ELEVATIONS: DATUM

CASING DIAM.

..... GROUND SURFACE

CORE DIAM.

..... WATER LEVELS

REMARKS: HNU BKed 0.2 PPM

LOG	DESCRIPTION: COLOR; CONSISTENCY DENSITY; TEXTURE; STRUCTURE; SHAPE AND SURFACE CONDITION OF GRAINS; ODOR; ETC.	ELEV. - DEPTH	SAMPLE				BLOWS PER INCH	NOTES: BORING; TESTING AND SAMPLING PROCEDURES; WATER LOSS AND GAIN; DRILLING AND TESTING EQUIPMENT; ETC.
			LISCs	NO.	SIZE (IN.)	RETD (IN.)		
	2" TOPSOIL						3	HNU 0.2 ppm
	10" Mixed Fill, Black Sand	1		1	12		9	
	Pink Sand, Brn/Red Slag				24		12	
		2					48	Difficult Augering
	Mixed Fill, Black						66	Black Slag Fragments
	Foundry Sand;	3		2	12		24	on Auger Flights
	Fire Bricks				24		7	HNU 0.2 ppm
		4					5	
	10" Green SAND (m-f)	5					11	tr Plant fragments in
	tr Clay/silt, some Grv/		SM	3	23		17	Lower 13"-Grading to Gray
	Damp to WET	6			24		14	in Lower 2"
	13" Sand/Grv little f Sand						14	SATURATED
		7					6	Gravelly Balled Clay on
	1" Clayey Gravel			4	3		9	Augers from 5' to 10'
	WET	8			24		11	
							4	
	WASH	9	GP	5	4		3	
					24		4	Pea Gravel - flat Shale
	WET	10					9	Fragments in Cuttings
	4" GRN CLAY little silt		CH				7	
	little f. Grv. 6" m	11	SM	6	22		8	HNU 0 ppm
	SAND, tr silt 8" Grv/		GP		24		12	Downgrade to Level D
	little m, Sand 4" f/m Sand	12	SM				30	
	tr silt							AB001749
		13						

**MALCOLM
PIRNIE**

Field Borehole Log

JOB NO. 0285-23-1 HOLE NO. PW-P SHEET NO. 2 OF 3

					Water w/ Cutting at 15'
Grey f/vf SAND to SILT laminated w/ occ. clay Lamina	15	7	$\frac{6}{24}$		
SAME occ. Black Organic Lamina	16	8	$\frac{8}{24}$	10 17 15 14	
7" Gry f/vf SAND to SILT Laminated WET	17	9	$\frac{8}{24}$	9 5 5 13	
WET	18				Dry in Spoon (1")
	19	SM			
	20				
	21				
	22				
	23				
	24				
	25				
SAME	26	10		3 13 22 48	
	27				
	28				
	29				
	30				
Gry f. SAND some SILT	31	11	$\frac{16}{24}$	6 12 12 57	Strong Dilation
WET	32				
	33				ABOUT 750
	34				

MALCOLM PIRNIE

Field Borehole Log

ORIGINAL
(RED)

CLIENT COE
PROJECT REMEDIAL DESIGN
SITE MILLCREEK
LOCATION EIRE PA
CONTRACTOR PENNA DRILLING
METHOD OF BORING: SOIL 6 1/4" Hollow Stem Auger
ROCK

JOB NO. 0285-23-1 HOLE NO. 26A SHEET NO. 1 OF 1
WEATHER Foggy SO's INSPECTOR RHO
TEMP. 55 STARTED 8:10 A.M. 5/6 1988
DIP 0 FINISHED 11:00 A.M. 5/6 1988
ELEVATIONS: DATUM
CASING DIAM.
CORE DIAM. GROUND SURFACE
WATER LEVELS

REMARKS: Location adj. to Soil BORING # 32

LOG	DESCRIPTION: COLOR; CONSISTENCY DENSITY; TEXTURE; STRUCTURE; SHAPE AND SURFACE CONDITION OF GRAINS; ODOR; ETC.	ELEV. DEPTH	SAMPLE				BLOWS PER 6 INCH	NOTES: BORING; TESTING AND SAMPLING PROCEDURES; WATER LOSS AND GAIN; DRILLING AND TESTING EQUIPMENT; ETC.
			USCS	NO.	SIZE (IN.)	RETD (IN.)		
MILL	Black foundry SAND	1	FILL	1	20 24		4 10 8 13	BEGIN AT LEVEL C
		2						
	Red Brick in Shoe	3		2	1 24		14 8 13 14	
		4						
	Wood Splinters in Shoe	5		3	0 24		10 5 3 2	Lead Auger Plugged by Iron and Bricks - Pulled Augers to clear and sample flights
	Black Sand	6						
	Wood Splinters, Limestone Fragments, Black Sand, Slag in Shoe	7		4	3 24			
	MOIST	8						
	Wood Splinters, Slag and Green Silty CLAY in Shoe	9		5	0 24		WR 6 3 3	
	WET	10						
	6" Black SAND & WOOD	11		6	22 24		2 3 6 12	
	WET 3" Black Organic Topsoil 4" Green SAND little Clay 9" Grey f-m SAND	12	SC	2 SM				MOIST
		13	SM					

AR001753

Field Borehole Log

ORIG.
(RED)

**MALCOLM
PIRNIE**

Field Borehole Log

CLIENT COE
 PROJECT REMEDIAL DESIGN
 SITE MILLCREEK
 LOCATION EIRE, PA
 CONTRACTOR PENN DRILLING
 METHOD SOIL 6 1/4" ID AUGERS
 OF BORING: ROCK

JOB NO. 0285-23 / HOLE NO. 263 SHEET NO. 1 OF 1
 WEATHER _____ INSPECTOR RHO
 TEMP. _____ °F STARTED 2:45 P.M. 5/9 1988
 DIP _____ ° FINISHED 3:45 P.M. 5/9 1988
 ELEVATIONS: DATUM _____
 CASING DIAM. _____
 CORE DIAM. _____ GROUND SURFACE _____
 WATER LEVELS _____

REMARKS: BOREHOLE LOCATED
10 FT FROM 26A

LOG	DESCRIPTION: COLOR; CONSISTENCY DENSITY; TEXTURE; STRUCTURE; SHAPE AND SURFACE CONDITION OF GRAINS; ODOR; ETC.	ELEV. - DEPTH	SAMPLE				BLOWS PER 6 INCH	NOTES: BORING; TESTING AND SAMPLING PROCEDURES; WATER LOSS AND GAIN; DRILLING AND TESTING EQUIPMENT; ETC.
			LISCS	NO.	SIZE (IN.)	RETD. (IN.)		
		1						AUGER TO 12 FT WITHOUT SAMPLING
		2						
		3						
		4						
		5						
		6						
		7						
		8						
		9						
		10						
		11						
		12						
	Grey M/F SAND						9	
	tr C. Sand	13		1			11	AR001756
	WET						9	

Field Borehole Log

JOB NO. 0285-23-1 HOLE NO. 268 SHEET NO. 2 OF 2

[illegible]

ORIGINAL
(RED)

MALCOLM PIRNIE

Field Borehole Log

CLIENT RE US ARMY COLE
 PROJECT REMEDIAL DESIGN
 SITE MILLCREEK
 LOCATION WIRE PA
 CONTRACTOR PENNY DRILLING
 METHOD SOIL 6 1/4" ID Auger
 OF
 BORING: ROCK

JOB NO. 028523-1 HOLE NO. 26C SHEET NO. 1 OF 1
 WEATHER Clear INSPECTOR RHC
 TEMP. 70 °F STARTED 1 PM M. 6/8 1983
 DIP ° FINISHED 3 PM M. 6/8 1983
 ELEVATIONS: DATUM
 CASING DIAM.
 CORE DIAM. GROUND SURFACE
 WATER LEVELS

REMARKS: Refer Boring Log for MW-26A

LOG	DESCRIPTION: COLOR; CONSISTENCY DENSITY; TEXTURE; STRUCTURE; SHAPE AND SURFACE CONDITION OF GRAINS; ODOR; ETC.	ELEV. DEPTH	SAMPLE				BLOWS PER 6 INCH	NOTES: BORING; TESTING AND SAMPLING PROCEDURES; WATER LOSS AND GAIN; DRILLING AND TESTING EQUIPMENT; ETC.
			LISCS	NO.	SIZE (IN.)	RET'D (IN.)		
								<u>Auger to 8 ft</u>
	<u>Black Foundry</u>	<u>1</u>						
	<u>sand and wood</u>							
	<u>splinters dry</u>	<u>2</u>						
	<u>cuttings</u>							
		<u>3</u>						
		<u>4</u>						
		<u>5</u>						
		<u>6</u>						
		<u>7</u>						
		<u>8</u>						
	<u>Wood in shoe</u>						<u>5</u>	
		<u>9</u>		<u>1</u>		<u>9/24</u>	<u>2</u>	
							<u>2</u>	
		<u>10</u>					<u>6</u>	
	<u>BLACK FOUNDRY SAND to 10.5'</u>			<u>2</u>		<u>3/24</u>	<u>5</u>	
	<u>MOIST to WET</u>	<u>11</u>						<u>Driller clean-out 6 1/4" Auger</u>
	<u>CLAYEY SAND</u>							<u>w/ 6" OD Auger to 11.2 ft</u>
	<u>MOIST</u>							<u>came up w/ 6" of clayey</u>
								<u>sand on Auger head</u>
								<u>WATER AT 11.265 below</u>
								<u>Ground in MW 26B</u>

AR 001758

ORIGINAL
(RED)MALCOLM
PIRNIE

Field Borehole Log

CLIENT ARMY COE JOB NO. _____ HOLE NO. 27A SHEET NO. _____ OF _____
 PROJECT REMEDIAL DESIGN WEATHER _____ INSPECTOR _____
 SITE MILLCREEK TEMP. _____ °F STARTED 10:10A.M. _____ 19____
 LOCATION EIRE, PA DIP _____ ° FINISHED _____ .M _____ 19____
 CONTRACTOR PENN. DRILLING ELEVATIONS: DATUM _____
 METHOD SOIL 6 1/4" ID AUGERS CASING DIAM. _____
 OF BORING: ROCK _____ GROUND SURFACE _____
 CORE DIAM. _____ WATER LEVELS _____

REMARKS:

LOG	DESCRIPTION: COLOR; CONSISTENCY DENSITY; TEXTURE; STRUCTURE; SHAPE AND SURFACE CONDITION OF GRAINS; ODOR; ETC.	ELEV. DEPTH	SAMPLE				BLOWS PER 6 INCH	NOTES: BORING; TESTING AND SAMPLING PROCEDURES; WATER LOSS AND GAIN; DRILLING AND TESTING EQUIPMENT; ETC.
			USCS	NO.	SIZE (IN.)	RETD (IN.)		
	4" BLACK SAND						40	
	3" SLAG FRAGMENTS	1		1	15		90	
	8" MIXED SLAG, FIRE BRICK				24		31	
	SILTY SAND FILL	2					70	
	DENSE, BR MIXTURE OF						36	
	BLACK SAND; BR SILTY	3	FILL	2	15		38	
	SAND w/ LG GRAVEL; FIRE BRICK				24		27	
	and SLAG FILL	4					33	
	Loose, SAME	5		3	3		4	
					24		12	
							16	
	MOIST FILL	6					16	
	Loose, GREEN/GRAY M to						3	
	F. SAND to Gravel to Silt	7	SW	4	6		2	
					24		3	
	WET	8					5	
	8" Green M to F SAND to Gravel						3	
	4" BROWN S/w/ Sand to Silt	9		6	14		3	NOTE: Lithologic Sequence from 8' to 12' was also observed at Loc 26A 14'-16'
	Laminated WET				24		3	
	2" Gravel w/ BR SILTY M to F	10					11	
	14" M to F GRAVEL						9	
	some C Sand to m Sand	11	GW	5	14		10	
					24		16	
	WET	12					12	
		13						
		14						

AR001759

**MALCOLM
PIRNIE**

Field Borehole Log

JOB NO. HOLE NO. SHEET NO. OF

						(2) FT GRAVEL CLEAN ^{ed} OUT OF AUGER AT 15 FT	
6" M to F GRAVEL little C. Sand. tr Cobbles 6"	15	GW			18	7	Clean-out Auger became Jammed
M to f SAND, 6" v f/v f SAND tr Silt WET	16	sm	7		24	15	SANDS
	17					22	SANDS are weakly
						31	laminated
	18						
	19						
	20						10 FT of Water in the hole at 20 FT
Grey f/v f SAND + silt/ Black (Organic?) laminations WET	21		8		12	6	Strong dilation
	22				24	8	
						10	
	23					19	
f Gravel & C-Sand	24		9		24	1	Perform Vertical Permeability Shallow Falling Head Test at 23 ft
	25					1	Sampled thru hole in
						5	Swash made by Testing Pipe
12" f GRAVEL & C Sand 12" f SAND Sand tr m Sand	26		10		24	8	Wash caved
	27				24	28	Believe that Gravel may be wash - high blow cts
	28					70	derive from driving a full spoon
	29					112	
	30						
12" f GRAVEL/C SAND grading to M SAND little Gravel WET	31		11		24	28	
12" f/v f SAND MOIST 6" SILT Hard DRY	32					30	
	33					130	
						100	SILT is Brn/wht Rock Flour
	34						Hard Augering at 33'
							AROG 1760

GREY

AR001760

Field Borehole Log

JOB NO. _____ HOLE NO. _____ SHEET NO. _____ OF _____

Depth (ft)	Soil Description	Moisture	Notes
35			
36	Hard Grey Silt, little Gravel 4"	ml	
37	16" Hard Gry Silt tr Gravel Dry		
38			
39			
40	Hard Grey Silt, tr Gravel tr Sand tr Clay	ml	
41			
42	Dry		
43			
44			
45			

AR001761

Field Borehole Log

CLIENT ARMY COE
PROJECT REMEDIAL DESIGN
SITE MILL CREEK
LOCATION FIRE, PA
CONTRACTOR PA DRILLING
METHOD OF BORING: SOIL 6 1/4" ID AUGER
ROCK

JOB NO. 0285-23-1 HOLE NO. 27B SHEET NO. 1 OF 2
WEATHER cool, clear INSPECTOR RHO
TEMP. °F STARTED 230 P M. 5/11 1988
DIP ° FINISHED M. 5/12 1988

ELEVATIONS: DATUM _____

CASING DIAM. _____ GROUND SURFACE _____
CORE DIAM. _____ WATER LEVELS _____

REMARKS: see Boring Log for MW 27A
Submitted Gravel Cuttings (10'-10') for Physical Testing

LOG	DESCRIPTION: COLOR; CONSISTENCY DENSITY; TEXTURE; STRUCTURE; SHAPE AND SURFACE CONDITION OF GRAINS; ODOOR; ETC.	ELEV. - DEPTH	SAMPLE				BLOWS PER 6 INCH	NOTES: BORING; TESTING AND SAMPLING PROCEDURES; WATER LOSS AND GAIN; DRILLING AND TESTING EQUIPMENT; ETC.
			USCS	NO.	SIZE (IN.)	RET'D (IN.)		
		1						Auger to 11 ft. and Perform Falling Head Borehole Permeability Test
		2						
		3						
		4						
		5						
		6						
		7						
		8						
		9						
		10						
		11						2 FT. of f → C Gravel cleaned out of auger at 11 ft
	2" f SAND					6	3	f sand settled out of Pipe
	6" m-f Gravel tr f-C Sand	12	GW	1		24	4	during Falling Head Test.
	tr Cobbles						6	
		13					7	
	6" m-f Gravel some m-c		GW	2		24	9	AK001762
	Sand tr Cobbles	14				24	10	

**MALCOLM
PIRNIE**

Field Borehole Log

JOB NO. _____ HOLE NO. _____ SHEET NO. _____ OF _____

8" m- ϕ GRAVEL Some C- ϕ
Sand tr Silt 6" m- ϕ Sand

15

16

17

18

10

13

Silt fraction of Gravel
is variable thru-out Spoon

Drilled to 16 ft w/ 6 $\frac{1}{4}$ "
ID Auger. Cleaned out
w/ 6" OD Auger at 16 ft.
Approx 1 cu yd of
m- ϕ Gravel tr Cobbles
Some m-C Sand was
produced while attempting
to clean-out auger at 16

Sand & Gravel may be
traveling down the flights
of the stationary 6 $\frac{1}{4}$ " auger
and supplying the
6" auger.

Source of Gravel is the
10 to 16 ft Interval

AR001763

ORIGINAL
(RED)

MALCOLM PIRNIE

Field Borehole Log

CLIENT C.O.F.
PROJECT Mill Creek
SITE _____
LOCATION Erie, PA
CONTRACTOR Penn Drill
METHOD SOIL 6 1/4" ID HS augers
OF _____
BORING: ROCK _____

JOB NO. 0285-231 HOLE NO. 28A SHEET NO. 1 OF _____
WEATHER Sunny INSPECTOR DLA
TEMP. 55/60°F STARTED 8:30 A.M. 5/3 1988
DIP 0 FINISHED 8:45 A.M. 5/4 1988

ELEVATIONS: DATUM _____

CASING DIAM. _____

GROUND SURFACE _____

CORE DIAM. _____

WATER LEVELS _____

REMARKS:

LOG	DESCRIPTION: COLOR; CONSISTENCY DENSITY; TEXTURE; STRUCTURE; SHAPE AND SURFACE CONDITION OF GRAINS; ODOR; ETC.	ELEV. DEPTH	SAMPLE				BLOWS PER 6 INCH	NOTES: BORING; TESTING AND SAMPLING PROCEDURES; WATER LOSS AND GAIN; DRILLING AND TESTING EQUIPMENT; ETC.
			USCS	NO.	SIZE (IN.)	RET'D (IN.)		
Glasgow Springs or Fill	4" dk br organic silts		OL			13	7	
	9" foundry sands / Fill	1	Fill	1	2	24	26	
	moist at bottom					24	21	
							27	
	broken gravel and sand /	2	CL	2	2	6	7	
	Fill little silt	3				11		
	Saturated *					24	4	
		4	SW				3	
	10" SILT + CLAY, tr f					18	4	
	sand, moist to damp	5		3	2	24	3	
	7" mixed SANDS, wet -		SP				5	tr gravel + silt
	1" f SAND, little silt, grey	6				7		
	f SAND, grey color,			4	2	15	5	
	little silt, saturated	7	GP			24	7	
	2" f GRAVEL, subrounded						8	
		8				14	1	
	f subrounded GRAVEL			5	2	24	1	
	saturated	9					4	
		10						
		11						
		12	SP					
		13						

AR001764

**MALCOLM
PIRNIE**

Field Borehole Log

JOB NO. 0285-231 HOLE NO. 28A SHEET NO. 2 OF 2

GLACIOLACUSTRINE		15					
	f SAND, tr silt						
	saturated						
		16	6	2"	12/24	5/5	
						5/10	
		17					
		18					
		19					
		20					
	11" of SAND, some silt						
	moist to wet						
	2" m/f SAND, tr silt		7	2"	13/24	5/10	
	saturated					10/15	
		22					
		23					
		24					
		25					
	f/m SAND, tr f subR						
	gravel, wet to		8	2"	22/24	7/10	
	saturated					11/25	
		27					
		28					
		29					
		30					
	f/vf SAND, tr of silt						
	and subR f gravel,		9	2"	20/24	6/16	
	saturated					40/54	
		32					
		33					
		34					

AR001765

**MALCOLM
PIRNIE**

Field Borehole Log

JOB NO. 0285-231 HOLE NO. 28A SHEET NO. 3 OF

		35	↑					
12" f/y f SAND		35				24	20	
saturated		36		10	2"	24	16	
12" f/m sub R GRAVEL		37	GP			24	24	
saturated		38					22	
		39	?					SANOS running up auger
		40						from 35 to 40 ft depth
		41	GW					
14" f/m sub R GRAVEL		42				24	6	Gravel coming up from
2" f SAND, saturated		43		11	2"	24	20	augers at 40 ft; sub R
5" f GRAVEL, some sand		44				24	20	f/m, tr of coarse,
mixed; saturated		45	ML				42	appeared to be 'clean,'
2" SILT, stratified, dry		46						though may contain some
1" SILT, uniform, damp		47						sands. Material is non-
		48						uniform. Note: Water poured
		49						out of hole prior to gravel
		50						coming up.
19 inches - Gravel Wash		51						
5" Dense Gry, SILT, some		52		12	2"	5/24	40	Green to Gry Shale fragments
C-f Sand, little Rock Fragments		53					100/5"	noted in Till
tr. Rounded Grvl. to Clay, TILL		54						damp to dry
		55						
		56						Auger to 48 ft to stop
		57						inflow of running sands,
		58						very difficult augering below
		59						45 ft - Due to dense TILL
		60						
		61						
**MALCOLM
PIRNIE**

Field Borehole Log

ORIGINAL
(RED)

CLIENT COE
PROJECT REMEDIAL DESIGN
SITE MILLCREEK
LOCATION FAIR, PA
CONTRACTOR PENN. DRILL
METHOD SOIL 6 1/4" Hollow Stem Auger
OF
BORING: ROCK

JOB NO. 0085231 HOLE NO. 28B SHEET NO. 1 OF 1
WEATHER RAIN INSPECTOR RHO
TEMP. 50 °F STARTED .M. 19
DIP ° FINISHED .M. 19
ELEVATIONS: DATUM
CASING DIAM.
CORE DIAM. GROUND SURFACE
WATER LEVELS

REMARKS: Adjacent to Borehole 28A

LOG	DESCRIPTION: COLOR; CONSISTENCY DENSITY; TEXTURE; STRUCTURE; SHAPE AND SURFACE CONDITION OF GRAINS; ODOR; ETC.	ELEV. DEPTH	SAMPLE				BLOWS PER 6 INCH	NOTES: BORING; TESTING AND SAMPLING PROCEDURES; WATER LOSS AND GAIN; DRILLING AND TESTING EQUIPMENT; ETC.
			LISCs	NO.	SIZE (IN.)	RET'D (IN.)		
		1						Auger to 10 ft
		2						
		3						
		4						
		5						
		6						
		7						
		8						
		9						
		10						
	24" of Fine Gravel C. SAND WASH	11		1		24 24	6 7 10 9	
	2" F. GRAVEL, same C. Sand 6" Olive F.M. SAND tr SILT	12	GP			14 24	9 11	AR001767
	4" Grey f/vf SAND 2" Olive F.M. SAND tr SILT	13	SP	2			18 24	f/vf Sand - inhibited Gravelly Sand in Shoe
		14						

tr Gravel

**MALCOLM
PIRNIE**

Field Borehole Log

CLIENT ARMY COE
PROJECT REMEDIAL DESIGN
SITE MILLCREEK
LOCATION ELITE, PA
CONTRACTOR PENN DRILLING
METHOD SOIL 6 1/4" ID AUGER
OF BORING: ROCK

JOB NO. 0285-23 HOLE NO. 29 SHEET NO. 1 OF 2
WEATHER cool cloudy INSPECTOR RHO
TEMP. 55 °F STARTED 9:30 A 5/17 1988
DIP ° FINISHED 11:00 A 5/17 1988

ELEVATIONS: DATUM

CASING DIAM.

GROUND SURFACE

CORE DIAM. WATER LEVELS

REMARKS:

LOG	DESCRIPTION: COLOR; CONSISTENCY DENSITY; TEXTURE; STRUCTURE; SHAPE AND SURFACE CONDITION OF GRAINS; ODOR; ETC.	ELEV. — DEPTH	SAMPLE				BLOWS PER 6 INCH	NOTES: BORING; TESTING AND SAMPLING PROCEDURES; WATER LOSS AND GAIN; DRILLING AND TESTING EQUIPMENT; ETC.
			LISCS	NO.	SIZE (IN.)	RETD. (IN.)		
	Loose, Brown C to m SAND some Silt, little tot. Clay tr Gravel	1		1	20 24		2 2 3 6	
		2						
		3						Gravelly loam w/ 2"-3" cobbles in cuttings to 5'
		4						
		5						
	Loose Brown C-M SAND some Silt tr Gravel to 6" WET, Same, but Grey to 14" MOIST	6	SW	2	14 24		5 5 3 4	
		7						
		8						Tr Clay in Cuttings at 7 ft
		9	GM					
		10						Brown, & Gravel, well Rounded WET at 9'
	SAME, Grey w/ Inter- bedded Silt, and & Sand tr C. Sand	11	SW	3	18 24		4 4 4 8	
	SATURATED	12						
		13						
		14						

AR001760

Field Borehole Log

Grey m. SAND, some
f Sand, tr Gravel

SP

4

$$\frac{12}{24}$$
$$\frac{10}{8}$$

7

17

9" SAME

9" Silt Some f/vf

Sand w/ Black, ...
organic laminatio

ml/sp

C

$$\begin{array}{r} 18 \\ \hline 24 \end{array}$$

7

19

25

3.

w. l. at 15.5' below Grd

AR001769

MALCOLM PIRNIE

Field Borehole Log

JRIG
(REL)

CLIENT ARMY COE
PROJECT REMEDIAL DESIGN
SITE MILLCREEK
LOCATION EIRE, PA
CONTRACTOR PENN. DRILLING
METHOD OF BORING: SOIL 6 1/4" ID AUGER
ROCK

JOB NO. 0285-23 HOLE NO. 30 SHEET NO. 1 OF 2
WEATHER Clear INSPECTOR RHO
TEMP. 65 °F STARTED 7:45 A.M. 5/23 1988
DIP..... FINISHED 9:30 A.M. 5/23 1988

ELEVATIONS: DATUM.....

CASING DIAM.

GROUND SURFACE

CORE DIAM. WATER LEVELS

REMARKS:

LOG	DESCRIPTION: COLOR; CONSISTENCY DENSITY; TEXTURE; STRUCTURE; SHAPE AND SURFACE CONDITION OF GRAINS; ODOR; ETC.	ELEV. DEPTH	SAMPLE				BLOWS PER 6 INCH	NOTES: BORING; TESTING AND SAMPLING PROCEDURES; WATER LOSS AND GAIN; DRILLING AND TESTING EQUIPMENT; ETC.
			LISCS	NO.	SIZE (IN.)	RETD (IN.)		
	DRK Brn Organic TOP SOIL						2	
		1		1	4	24	3	
							2	
		2					1	
		3						Dark Brn - grading to light Brn SAND some silt with clay
		4						tr Gravel in Cuttings to 5 ft
		5						MOIST
	BRN SAND (M-F) some Gravel (1/8-1/2") tr	6	SP	2	12	24	8	Shoe Pushed Large Cobble
	Silt over Gry C-M SAND						14	
	Some Gravel WET	7					6	
	SATURATED						4	WATER IN SAMPLE HOLE
		8						HARD DRILLING AT 8 FT
		9						Encountered large cobbles w/Significant % fines at 8 ft
		10						in Cuttings
	Gray GRAVEL (1/8-1")		GW		6	24	4	
	little Sand tr Silt	11		3			4	WATER AT 5.5 ft
	Grv) sub rounded to						7	
	subangular SATURATED	12					3	
		13						Cobbles (to 2" long)
		14						in Cuttings to 0.5 ft

AR 001770

Field Borehole Log

JOB NO. 0285-23-1 HOLE NO. 30 SHEET NO. 2 OF 2

[illegible]

**MALCOLM
PIRNIE**

Field Borehole Log

CLIENT ARMY COE
PROJECT REMEDIAL DESIGN
SITE MILL CREEK
LOCATION FIRE, PA
CONTRACTOR PENN. DRILLING
METHOD OF BORING: SOIL 6 1/4" ID AUGER
ROCK

JOB NO. 0285-23 - HOLE NO. 31 SHEET NO. 1 OF 2

WEATHER cloudy INSPECTOR RHO

TEMP. 50 °F STARTED 8 A M. 5/18 1988

DIP..... • FINISHED 10 A.M. 5/18 1988

ELEVATIONS: DATUM _____

CASING DIAM.

.....GROUND SURFACE.....

CORE DIAM. WATER LEVELS

REMARKS: SAMPLES RETAINED IN ONE JAR
FROM 10-12', 15-12', and CUTTINGS
FROM 12-15'

[illegible]

Field Borehole Log

JOB NO. 285-23-1 HOLE NO. 31 SHEET NO. 2 OF 2

	15	GP					
Gravel $\frac{1}{8}$ " - $\frac{3}{8}$ "	16		4	$\frac{4}{24}$	$\frac{2}{10}$	Clean - free of fines	
tr Sand	17				$\frac{13}{7}$		
	18						
	19					Harder Drilling at 18 ft	
	20						
Grey m to f SAND	21	SP	5	$\frac{20}{24}$	$\frac{4}{6}$	well sorted	
tr Silt	22				$\frac{12}{13}$		
	23						
	24						
	25						
9" SAME w/tr Gravel	26		6	$\frac{14}{24}$	$\frac{4}{9}$	Top of Lacustrine	
5" f/vf Grey SAND	27	SM/ML			$\frac{9}{12}$	Fine Sands.	
tr Silt							
						Water level at completion	
						of borehole 2.5 ft	
						below Ground	

ORIGINAL
(RED)MALCOLM
PIRNIE

Field Borehole Log

CLIENT ARMY COE
 PROJECT REMEDIAL DESIGN
 SITE MILL CREEK
 LOCATION FIRE, PA
 CONTRACTOR PENN DRILLING
 METHOD SOIL 6 1/4" ID Augers
 OF BORING: ROCK

JOB NO 028523-1 HOLE NO. 32 SHEET NO. 1 OF 2
 WEATHER Cloudy INSPECTOR RHO
 TEMP. 45 °F STARTED 11:10 A.M. 5/25 1988
 DIP ° FINISHED 12:05 P.M. 5/25 1988

ELEVATIONS: DATUM

CASING DIAM.

GROUND SURFACE

CORE DIAM. WATER LEVELS

REMARKS: ON SWAP-TITE INC PROPERTY

LOG	DESCRIPTION: COLOR; CONSISTENCY DENSITY; TEXTURE; STRUCTURE; SHAPE AND SURFACE CONDITION OF GRAINS; ODOR; ETC.	ELEV. DEPTH	SAMPLE				BLOWS PER 6 INCH	NOTES: BORING; TESTING AND SAMPLING PROCEDURES; WATER LOSS AND GAIN; DRILLING AND TESTING EQUIPMENT; ETC.
			LISCs	NO.	SIZE (IN.)	RETD (IN.)		
ABLATION TILL	2" TOPSOIL 6" GRAVEL/SAND						12	
	FILL 4" CLAYEY SILT some	1		1		12	9	
	5 1/4" Sand, Tr Clay Tr Gravel					24	4	
	Hard FRAGIPAN 2" PEAT	2					8	
		3						Gray Brown Dry to damp
		4						Clayey Silt some f sand tr rounded Gravel in cutting
		5						to 5 ft - TILL?
	BRN mottled Red GRAVEL					10	5	Water in Sample hole
	AND C SAND, some	6	GM/ SH	2		24	5	
	SILT						5	Easier Drilling at 6-7 ft
	SATURATED	7					2	
		8						Same material in cutting
		9						to 10 ft
		10	GP/ SP					
		11		3		0	4	Fine gravel in 2" cut
						24	2	wash
							1/1R	Resampled to 13 ft
							1/1R	
	2" Silty Clayey Gravel			4		4	1	
	2" GRAVEL some C SAND	13				24	7	
	Loose SATURATED	14						AR001774

MALCOLM PIRNIE

Field Borehole Log

CLIENT COE
PROJECT MILLCREEK REM. DESIGN
SITE MILLCREEK
LOCATION FIRE PA
CONTRACTOR PA DRILLING
METHOD SOIL 6 1/4" ID AUGERS
OF
BORING: ROCK

JOB NO. _____ HOLE NO. 33A SHEET NO. 1 OF 3
WEATHER SUNNY INSPECTOR RHO
TEMP. 65 °F STARTED 10:30 A.M. 4/26 1988
DIP - ° FINISHED - M - 19-
ELEVATIONS: DATUM _____
CASING DIAM. _____
GROUND SURFACE _____
CORE DIAM. _____ WATER LEVELS _____

REMARKS: HNU Bkgd. 0.2 ppm
SUBMIT SAMPLES S-11 AND S-12 (COMPOSITE)
for PHYSICAL TESTING

LOG	DESCRIPTION: COLOR; CONSISTENCY DENSITY; TEXTURE; STRUCTURE; SHAPE AND SURFACE CONDITION OF GRAINS; ODOR; ETC.	ELEV. DEPTH	SAMPLE				BLOWS PER 6 INCH	NOTES: BORING; TESTING AND SAMPLING PROCEDURES; WATER LOSS AND GAIN; DRILLING AND TESTING EQUIPMENT; ETC.
			USCS	NO.	SIZE (IN.)	RET'D (IN.)		
FILL	Black Sand Fill w/ concrete	1	SM	1		18 24		0.4-0.6 ppm
		2						
	Red Brk. Black Sand	3	SM	2		6 24		0.8-1.0 ppm
		4						
	Black Sand w/ clay organic material	5	SM/CL	3		14 24		0.4-0.6 ppm
	MOIST	6						
	Black Sand w/ Clay FILL over Grey CLAYEY SILT	7	CL	4		14 24		0.4-0.6 ppm
	little Gravel 1/8" - 9" Poorly Graded MOIST	8						
	Grey to Black GRAVEL little Sand to Silt	9	GW	5		18 24		.2 ppm 3 Background DRILL CHATTER AT 8-9 FT
	Well Graded WET	10						COARSE 1"-2" GRAVEL in cuttings
NEAR SHORE LACUSTRINE	10" Gry Well Graded SAND/GRAVEL		GW				4	1:40 PM Static Wt at 6.0 FT
	5" Grey SILT	11	ML	6		19 24	5	
	4" Grey CLAYEY SILT w/ Black laminae WET	12	CL				9 13	
		13						
		14					1	AR001776

MALCOLM PIRNIE

Field Borehole Log

JOB NO. HOLE NO. 33A SHEET NO. 2 OF 3

NEAR SHORE LACUSTRINE		15						
	14' Gr. GRAVEL (Fine) Grades to Med SAND tr Silt over	16	GP/SP	7	24	9	Water Rises Outside Auger	
	10' SILT tr Sand	17			24	12		
	WET	18				14		
		19				14		
		20					5' Running Sands up Auger Clean 6" Auger w/ 3" Auger	
	Grey Fine SAND tr Silt NO APPARENT LAYERING	21	SM	8	24	WR 4	5' H.V. 0 to 0.4 PPM. ERRATIC	
	WET	22			24	8	Strong Dilation	
		23				7		
		24						
OFF SHORE LACUSTRINE		25					Spoon Dropped Down Hole Before Driving	
	Very Dense Fine SAND tr Silt	26	SM	9	24	24	Strong Dilation	
	WET	27			24	50/5"		
		28						
		29						
		30						
	16" Grey Dense Fine SAND Grading to C to M SAND	31	SM	10	24	62	6 7" C. SAND / F. GRAVEL LENS IN FINE SAND UNIT	
	Some Fine Gravel over 8" Fine SAND Some SILT	32			24	120		
		33				100/1"	WET	
		34						

AKU01777

ORIGINAL
(RED)

**MALCOLM
PIRNIE**

Field Borehole Log

JOB NO. HOLE NO. 33A SHEET NO. 3 OF 3

GLACIOLACUSTRINE (OFF SHORE)		35						
	Grey Very Dense F. to M. SAND little Silt, tr C. Sand	36	SM	11	24 24	12 110 100/L	SAND is up Augers: high blow counts due to driving a partially full spoon	
	WET	32						
		38						
		39					Cuttings coming up as a slurry - very Wet	
		40						
	Grey Dense F to M SAND little SILT. WET	41	SM	#1 12	24 24	11 21 28		
	4" Grey SILT little SAND tr Gravel TILL	42		#2		36		
	12" Fine/Med SAND - WASH 12" Grey SILT AND SAND	43	ML	13	12 24	16 24 28 50	Water level 13 ft 7:15 AM 4/27 Augered w/ 6" OD to 42' to clean-out Hole - But hole filled in to ~ 41 ft	
	Tr to little Gravel - well rounded to subangular MOIST TILL	44						
TILL	Grey Green Dense SILT and CLAY, little Gravel - Sub -	45	ML	14	15 24	8 28 32 34	AUGER w/ 10" OD To 44' for confirmation	
	Angular Shale Fragments to Well Rounded Sst. Pebbles DRY	46						
		47					Water level 4/28/88 9:50 AM 5.4' below Ground Surface	
		48						
		49						
		50						
		51						
		52						
		53					AR001778	

**MALCOLM
PIRNIE**

Field Borehole Log

CLIENT ARMY COE
PROJECT REM. DESIGN
SITE MILLCREEK.
LOCATION EIRE, PA
CONTRACTOR PENN. DRILLING
METHOD OF BORING: SOIL 6 1/2 ID AUGER
ROCK

JOB NO. 285-23-1 HOLE NO. 33B SHEET NO. 1 OF 1

WEATHER COLD INSPECTOR RHG

TEMP. _____ °F STARTED 10 A .M. 4/28 1961

DIP..... • FINISHED... 11 A .M. 4/28... 1988

ELEVATIONS: DATUM

CASING DIAM......

..... GROUND SURFACE

CORE DIAM. _____ WATER LEVELS _____

REMARKS: Submit samples 1 and 2 (composite) for physical testing.

LOG	DESCRIPTION: COLOR; CONSISTENCY DENSITY; TEXTURE; STRUCTURE; SHAPE AND SURFACE CONDITION OF GRAINS; ODOR; ETC.	ELEV. DEPTH	SAMPLE				BLOWS PER 6 INCH	NOTES: BORING; TESTING AND SAMPLING PROCEDURES; WATER LOSS AND GAIN; DRILLING AND TESTING EQUIPMENT; ETC.
			USCS	NO.	SIZE (IN.)	RETD (IN.)		
		1						
		2						
		3						
		4						
		5						
		6						
		7						
		8						
NEAR SHORE LACUSTRINE	3" Brown SAND and GRAVEL well Graded - grading to Med. SAND to Gravel to Silt w occ Cobble WET	9	GW	1		18 24		
	6" Grey Fine Gravel and Sand w some Silt - over	11	GC/ SP	2		13 24	muddy Gravel	
	7" Med SAND w/ 1" Muddy Gravel and 1" →	12					laminated Clay layer	
	10" Muddy Gravel over	13	GC/ SM	3		12 12		
	2" Fine Sand	14					AR001779	

ORIGINAL
(RED)

MALCOLM PIRNIE

Field Borehole Log

CLIENT ARMY COE
PROJECT REMEDIAL DESIGN
SITE MILLCREEK
LOCATION FIRE PA
CONTRACTOR PENN DRILL
METHOD SOIL 6 1/4" ID AUGER
OF BORING: ROCK

JOB NO. 0285-23-1 HOLE NO. 34 SHEET NO. 1 OF 2
WEATHER CLEAR INSPECTOR RND
TEMP WARM STARTED 3 P M. 5/12 1988
DIP FINISHED M. 19.....
ELEVATIONS: DATUM
CASING DIAM.
GROUND SURFACE
CORE DIAM. WATER LEVELS

REMARKS: SEE SOIL BORING LOG SB-46
FOR 0-5 FT

LOG	DESCRIPTION: COLOR; CONSISTENCY DENSITY; TEXTURE; STRUCTURE; SHAPE AND SURFACE CONDITION OF GRAINS; ODOR; ETC.	ELEV. DEPTH	SAMPLE				BLOWS PER 6 INCH	NOTES: BORING; TESTING AND SAMPLING PROCEDURES; WATER LOSS AND GAIN; DRILLING AND TESTING EQUIPMENT; ETC.
			LISC	NO.	SIZE (IN.)	RETD (IN.)		
MILLCREEK		1	SP					• DRILL TO 5 FT w/OUT SAMPLING
		2						
		3						
		4						
		5						
	Black Foundry Sand 18"	6	ML	1	18 24		1 2 2	There is a 2" Saturated Layer in the Sand at 18"
	Black Silty clay in shoe	7						
	7" Black Foundry Sand	8		2	16 24		4 6 4	Contact at 7'70"
	3" BRN/BLK TOPSOIL	9	ML					f. Sand, little clay tr.
	Clayey Sandy Silt	10		3	16 24		4 5 13	Saturated zones most in Sand w/in
	6" GREEN SILT, some	11	GM					Green Silt - Saturated
	6" Same	12	ML					most in Gravel
	3" Same - mottled BRN	13		4	21 24		8 10 10	Plant Fragments & brown oxidation haloes around
	7" GRRAVEL some c-f	14	GW					Dirty Gravel w/ significant Fines w/ to Saturated
	Sand little Silt			5	24 24		5 9	AND 01700 soil Sorted

Field Borehole Log

JOB NO. _____ HOLE NO. 34 SHEET NO. _____ OF _____

[illegible]

ORIGINAL
(RED)MALCOLM
PIRNIE

Field Borehole Log

CLIENT ARMY COE
 PROJECT REMEDIAL DESIGN
 SITE MILL CREEK
 LOCATION EIRE, PA
 CONTRACTOR PENNA. DRILLING
 METHOD SOIL 6 1/4" ID AUGERS
 OF BORING: ROCK

JOB NO. 0285-23-1 HOLE NO. 35 SHEET NO. 1 OF 2
 WEATHER CLOUDY, WET INSPECTOR RHO
 TEMP. 55 ° STARTED 11:00 P.M. 5/24 1981
 DIP.....° FINISHED.....M.....19.....

ELEVATIONS: DATUM.....

CASING DIAM.

GROUND SURFACE

CORE DIAM. WATER LEVELS

REMARKS: In Front of # 1217 Harper Dr.

LOG	DESCRIPTION: COLOR; CONSISTENCY DENSITY; TEXTURE; STRUCTURE; SHAPE AND SURFACE CONDITION OF GRAINS; ODOR; ETC.	ELEV. DEPTH	SAMPLE				BLOWS PER 6 INCH	NOTES: BORING; TESTING AND SAMPLING PROCEDURES; WATER LOSS AND GAIN; DRILLING AND TESTING EQUIPMENT; ETC.
			USCS	NO.	SIZE (IN.)	RET'D (IN.)		
PENT	Brn Black Silty Sand w/ tr wood fragments - appears natural - 2" Gravelly fragments	1		1		10 24	2 4 4	Highly Organic - Sand Almost a Peat
	2" Same as above in Shoe	2					6	
		3						Dark Brown grading to Lt Brn fine Gravel and Sand
		4						Some Silt in Cuttings to 5'
		5						Mottled Grn/Red/Brn Clayey Silt cleaned out from Auger at 5'
Fluvial or Beach Gravels	Grn/Mottled Gray Gravel and m. Sand - grading to Gray m SAND - little Grv SATURATED	6		2		10 24	8 9 6 7	Water in Sample hole
		7						
		8						in
		9						2" to 3" cobbles in Dk Brn silty Sand in Cuttings to 10'
		10						A cobbly sand
	Brn. Clay SAND little f sand tr Gravel Loose Wash	11		3		1" 24	1 1 1	NO Recovery 1st Attempt 1" on Rec. on 2nd Attempt
	SATURATED	12	GP				1	
	Brn GRAVEL (to 1/2") little f-m Sand - Loose Wash	13		4		6 24	1 2 3	
	SATURATED	14						AR001782

ORIGINAL
(RED)**MALCOLM
PIRNIE****Field Borehole Log**

CLIENT U.S. ARMY COE
 PROJECT REMEDIAL DESIGN
 SITE MILLCREEK
 LOCATION FIRE PA
 CONTRACTOR PENN. DRILLING
 METHOD SOIL 6Y4" ID AUGERS
 OF
 BORING: ROCK

JOB NO. 0285-23 / HOLE NO. 36 SHEET NO. 1 OF 1
 WEATHER Clear INSPECTOR RHC
 TEMP. 72 °F STARTED 3:00 P.M. 6/8 1984
 DIP ° FINISHED 4:00 P.M. 6/8 1984
 ELEVATIONS: DATUM
 CASING DIAM. GROUND SURFACE
 CORE DIAM. WATER LEVELS

REMARKS: LOC. IS 15 ft SE of MW-15A
SEE BORING LOG FOR 15A

LOG	DESCRIPTION: COLOR; CONSISTENCY DENSITY; TEXTURE; STRUCTURE; SHAPE AND SURFACE CONDITION OF GRAINS; ODOR; ETC.	ELEV. DEPTH	SAMPLE				BLOWS PER 6 INCH	NOTES: BORING; TESTING AND SAMPLING PROCEDURES; WATER LOSS AND GAIN; DRILLING AND TESTING EQUIPMENT; ETC.
			USCS	NO.	SIZE (IN.)	RETD (IN.)		
FILL	Black Foundry Sand in Cuttings	1	SM					DRILL TO 8'
		2						
		3						
	Wood Splinters and Plastic w/ Sand in Cuttings	4						
		5						
		6						
		7						
		8						
	3" Brown Sand w/ Brick Fragments 3" Wood Splinters	9		1	2"	6/24	5 4 4 3	
	Wood Splinters w/ SAND	10					7 5 5 8	Cuttings from 10 ft are moist Black (Foundry) Sand m-s Sand
	3" BRN Sand 2" Wood 1" BLK Foundry Sand 2" BRN BLK clayey	11		2	2"	2/24		
		12						
		13		3	2"	18/24	5 6	upper 2" of natural soil is Retained Sp. - clay is
	SILT w/ Roots 10" Grn Brn Gr	14					5	mottled + very Plastic w/ Abundant plant fragments
	Silty CLAY moist - Plant Fragments						5	


AR 00 17 84

MALCOLM
PIRNIE

OVERBURDEN
MONITORING WELL SHEET

ORIGINAL
(RED)


PROJECT <u>MILLCREEK</u>		LOCATION <u>EIRE PA</u>		DRILLER <u>EARL DYE</u>	
PROJECT NO. <u>0285-23-1</u>		BORING <u>PW</u>		DRILLING METHOD <u>8 1/4" ID AUGER</u>	
ELEVATION <u>713.87</u>		DATE <u>6-7-88</u>		DEVELOPMENT METHOD <u>SURGE/BAIL</u>	
FIELD GEOLOGIST <u>RH O'LASKEY</u>					

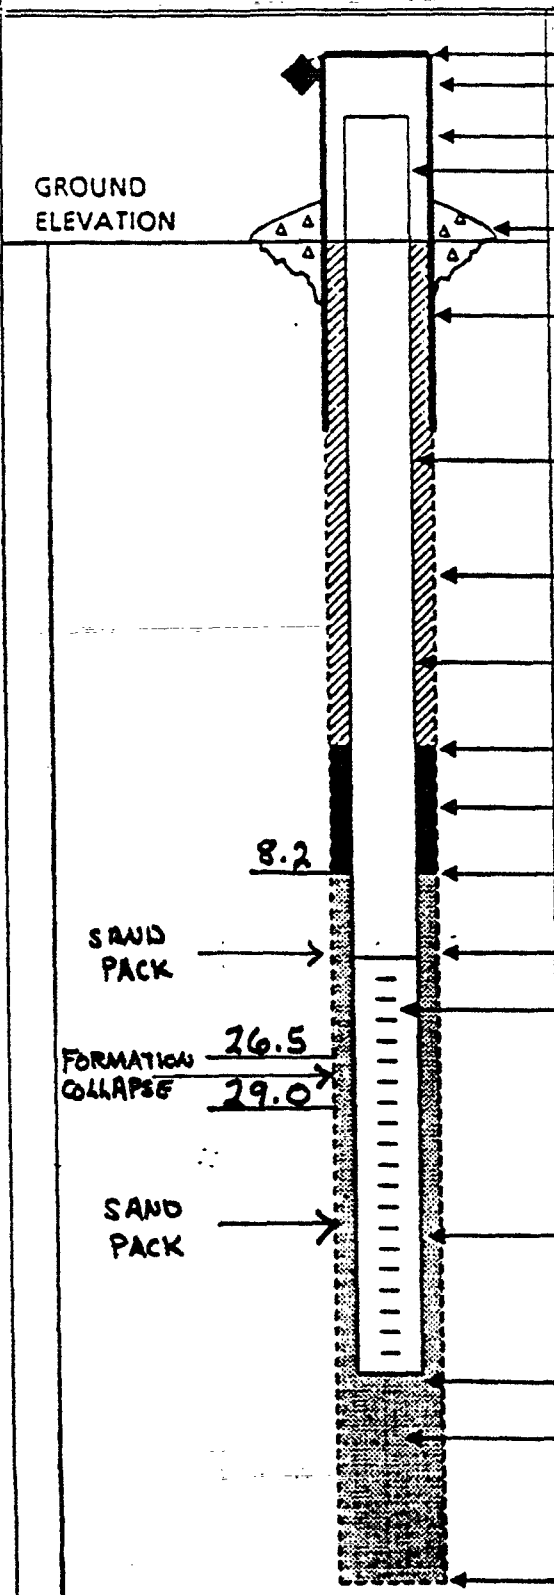	ELEVATION OF TOP OF SURFACE CASING :	<u>716.47</u>
	ELEVATION OF TOP OF RISER PIPE :	<u>716.11</u>
	STICK - UP TOP OF SURFACE CASING :	
	STICK - UP RISER PIPE :	<u>2.24</u>
	TYPE OF SURFACE SEAL: <u>CEMENT</u>	
	I.D. OF SURFACE CASING: <u>8"</u>	
	TYPE OF SURFACE CASING: <u>STEEL</u>	
	RISER PIPE I.D. <u>6"</u>	
	TYPE OF RISER PIPE: <u>FLUSH THREAD SCH 40 PVC</u>	
	BOREHOLE DIAMETER: <u>12"</u>	
	TYPE OF BACKFILL: <u>CEMENT/BENTONITE GROUT</u>	
	DEPTH TOP OF SEAL: <u>5.3</u>	
	TYPE OF SEAL: <u>BENTONITE PELLETS</u>	
	DEPTH TOP OF SAND PACK: <u>8.2</u>	
	DEPTH TOP OF SCREEN: <u>12.0</u>	
TYPE OF SCREEN: <u>CONTINUOUS WRAP PVC</u>		
SLOT SIZE x LENGTH: <u>.010" x 30 ft</u>		
I.D. OF SCREEN: <u>6"</u>		
<u>NOT FLUSH THREADED</u>		
TYPE OF SAND PACK: <u>#1 G-ROC</u>		
DEPTH BOTTOM OF SCREEN: <u>42.0</u>		
DEPTH BOTTOM OF SAND PACK: <u>44.0</u>		
TYPE OF BACKFILL BELOW OBSERVATION WELL: <u>#1 G-ROC</u>		
ELEVATION / DEPTH OF HOLE: <u>AR001785 44.0</u>		

**MALCOLM
PIRNIE**

**OVERBURDEN
MONITORING WELL SHEET**

PROJECT <u>Millcreek</u>	LOCATION <u>Eric, PA</u>	DRILLER <u>Penn Drill</u>
PROJECT NO. <u>0285-23-1</u>	BORING <u>OW #1</u>	DRILLING METHOD <u>6 1/4" HSA</u>
ELEVATION _____	DATE <u>6/2/88 (installed)</u>	DEVELOPMENT <u>Surge / Bail +</u>
FIELD GEOLOGIST <u>D. Aloysius</u>		METHOD <u>Air Lift</u>

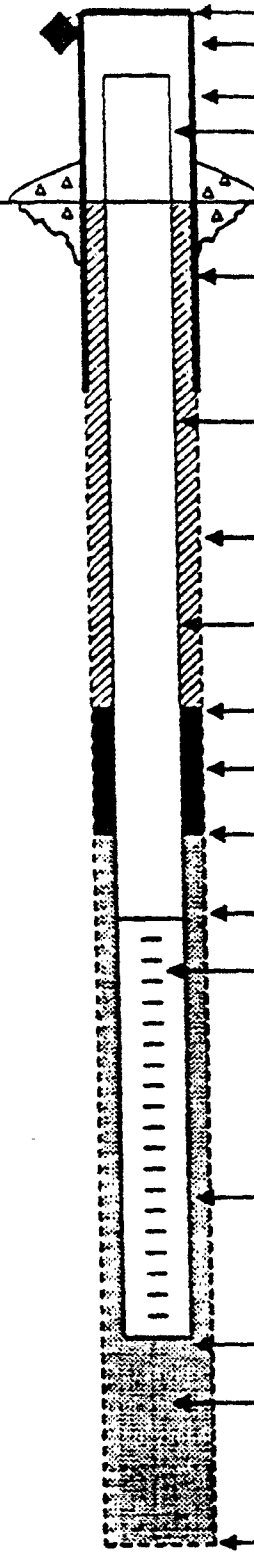
	ELEVATION OF TOP OF SURFACE CASING: <u>716.41</u>
	ELEVATION OF TOP OF RISER PIPE: <u>716.21</u>
	STICK-UP TOP OF SURFACE CASING: <u>2.3'</u>
	STICK-UP RISER PIPE: <u>~ 2'</u>
	GROUND ELEVATION _____
	TYPE OF SURFACE SEAL: <u>Cement / Bentonite Grout</u>
	I.D. OF SURFACE CASING: <u>4-inch</u>
	TYPE OF SURFACE CASING: <u>Steel</u>
	RISER PIPE I.D.: <u>2-inch</u>
	TYPE OF RISER PIPE: <u>PVC</u>
	BOREHOLE DIAMETER: <u>10"</u>
	TYPE OF BACKFILL: <u>Cement / Bentonite Grout</u>
	DEPTH TOP OF SEAL: <u>4.5'</u>
	TYPE OF SEAL: <u>Bentonite pellet</u>
	DEPTH TOP OF SAND PACK: <u>7.5'</u>
DEPTH TOP OF SCREEN: <u>12'</u>	
TYPE OF SCREEN: <u>PVC</u>	
SLOT SIZE x LENGTH: <u>10 Slot / 30'</u>	
I.D. OF SCREEN: <u>2-inch</u>	
TYPE OF SAND PACK: <u>#2 G-ROK med Sand</u>	
DEPTH BOTTOM OF SCREEN: <u>42'</u>	
DEPTH BOTTOM OF SAND PACK: <u>42'</u>	
TYPE OF BACKFILL BELOW OBSERVATION WELL: _____	
ELEVATION / DEPTH OF HOLE: <u>AR001786 42'</u>	

**MALCOLM
PIRNIE**

**OVERBURDEN
MONITORING WELL SHEET**

ORIGINAL
(RED)

PROJECT <u>MILLCREEK</u>	LOCATION <u>SIRB PA</u>	DRILLER <u>EARL DYE</u>
PROJECT NO. <u>0285-23-1</u>	BORING <u>26A</u>	DRILLING
ELEVATION <u>721.81</u>	DATE <u>5-9-88</u>	METHOD <u>6Y4" ID AUGER</u>
FIELD GEOLOGIST <u>R H O'LASKEY</u>		DEVELOPMENT
		METHOD <u>SURGE / BAIL / AIR</u>

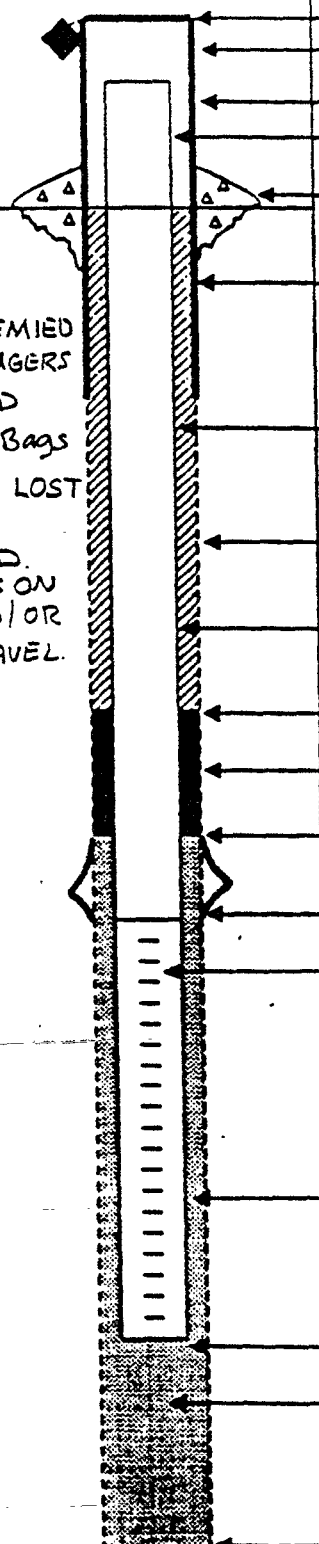
GROUND ELEVATION  GROUT TREMIED THROUGH AUGERS - REQUIRED (23) 90 lb. Bags GROUT WAS LOST INTO FILL (NOTE WOOD SPLINTERS ON LOG) AND/OR INTO GRAVEL.	ELEVATION OF TOP OF SURFACE CASING :	<u>724.31</u>
	ELEVATION OF TOP OF RISER PIPE :	<u>724.01</u>
	STICK - UP TOP OF SURFACE CASING:	
	STICK - UP RISER PIPE :	<u>2.20'</u>
	TYPE OF SURFACE SEAL: <u>CEMENT</u>	
	I.D. OF SURFACE CASING: <u>6"</u>	
	TYPE OF SURFACE CASING: <u>STEEL</u>	
	RISER PIPE I.D. <u>4"</u>	
	TYPE OF RISER PIPE: <u>PVC</u>	
	BOREHOLE DIAMETER: <u>10 1/2"</u>	
	TYPE OF BACKFILL: <u>CEMENT/BENTONITE GROUT</u>	
	DEPTH TOP OF SEAL:	<u>19.0'</u>
	TYPE OF SEAL: <u>BENTONITE PELLETS</u>	
	DEPTH TOP OF SAND PACK:	<u>20.5'</u>
	<u>CENTRALIZER</u>	
DEPTH TOP OF SCREEN:	<u>22.0'</u>	
TYPE OF SCREEN: <u>4" ID PVC</u>		
SLOT SIZE x LENGTH: <u>10 SLOT x 5 FT</u>		
I.D. OF SCREEN: <u>4"</u>		
TYPE OF SAND PACK: <u>#2 Q-ROC</u>		
DEPTH BOTTOM OF SCREEN:	<u>27.0'</u>	
DEPTH BOTTOM OF SAND PACK:	<u>28.0'</u>	
TYPE OF BACKFILL BELOW OBSERVATION WELL: <u>1' PELLETS 3' #2 Q-ROC</u>		
<u>8' CAVED FORMATION</u>		
ELEVATION / DEPTH OF HOLE: <u>AR001787 40'</u>		

**MALCOLM
PIRNIE**

**OVERBURDEN
MONITORING WELL SHEET**

PROJECT MILLCREEK LOCATION FIRE - PA
PROJECT NO. 0285-23-1 BORING 26B
ELEVATION 721.90 DATE 5-9-88
FIELD GEOLOGIST R.H. O'ASKAY

DRILLER GARL DYE
DRILLING
METHOD 6 1/4" ID AUGER
DEVELOPMENT
METHOD SURGE/BAIL

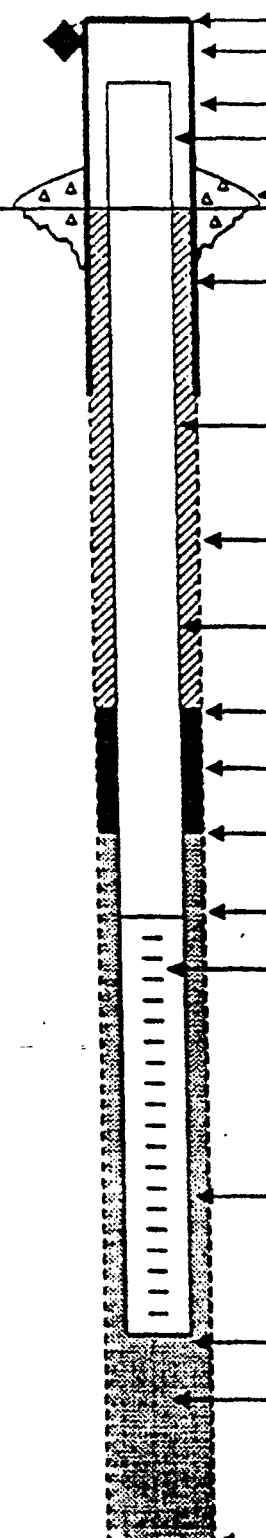	ELEVATION OF TOP OF SURFACE CASING:	<u>724.25</u>
	ELEVATION OF TOP OF RISER PIPE:	<u>723.92</u>
	STICK - UP TOP OF SURFACE CASING:	
	STICK - UP RISER PIPE:	<u>2.02'</u>
	TYPE OF SURFACE SEAL:	<u>CEMENT</u>
	I.D. OF SURFACE CASING:	<u>6"</u>
	TYPE OF SURFACE CASING:	<u>STEEL</u>
	RISER PIPE I.D.:	<u>4"</u>
	TYPE OF RISER PIPE:	<u>SCH 40 PVC</u>
	BOREHOLE DIAMETER:	<u>10 1/2"</u>
	TYPE OF BACKFILL:	<u>CEMENT/BENTONITE GROUT</u>
	DEPTH TOP OF SEAL:	<u>7.0'</u>
	TYPE OF SEAL:	<u>BENTONITE PELLETS</u>
	DEPTH TOP OF SAND PACK:	<u>9.1'</u>
	DEPTH TOP OF SCREEN:	<u>10.25'</u>
	TYPE OF SCREEN:	<u>PVC</u>
	SLOT SIZE x LENGTH:	<u>10 SLOT x 5 ft</u>
	I.D. OF SCREEN:	<u>4"</u>
TYPE OF SAND PACK:	<u># 2 G-ROC</u>	
DEPTH BOTTOM OF SCREEN:	<u>15.25'</u>	
DEPTH BOTTOM OF SAND PACK:	<u>16.0</u>	
TYPE OF BACKFILL BELOW OBSERVATION WELL:	<u># 2 G-ROC</u>	
ELEVATION / DEPTH OF HOLE:	<u>16.0'</u>	

GROUND ELEVATION


AR001788

**MALCOLM
PIRNIE**

**OVERBURDEN
MONITORING WELL SHEET**

ORIGINAL
(RED)

PROJECT <u>MILLCREEK</u>	LOCATION <u>BIRE - PA</u>	DRILLER <u>EARL DYE</u>
PROJECT NO. <u>0285-23-1</u>	BORING <u>26C</u>	DRILLING METHOD <u>6 1/4" ID AUGER</u>
ELEVATION _____	DATE <u>6-8-88</u>	DEVELOPMENT METHOD <u>NONE</u>
FIELD GEOLOGIST <u>RH O'LASKEY</u>		

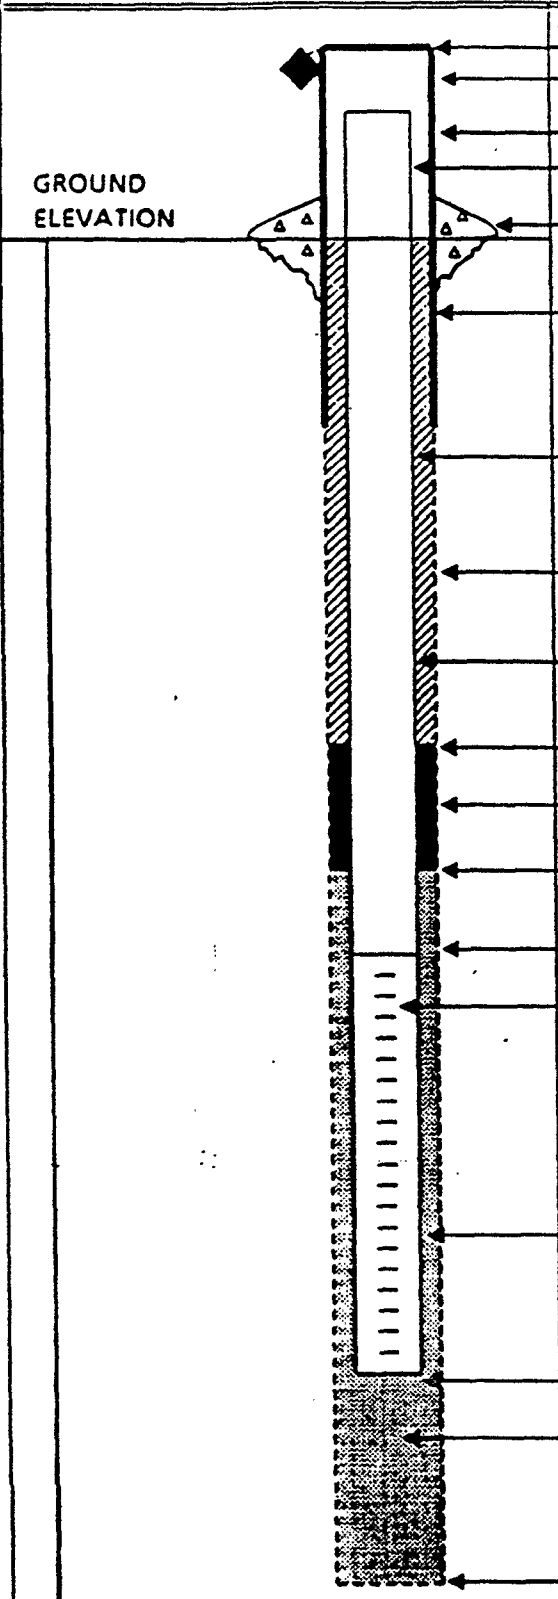	ELEVATION OF TOP OF SURFACE CASING: <u>724.53</u>
	ELEVATION OF TOP OF RISER PIPE: <u>723.92</u>
	STICK - UP TOP OF SURFACE CASING: <u>~ 2.7'</u>
	STICK - UP RISER PIPE: <u>~ 2.1'</u>
	TYPE OF SURFACE SEAL: <u>CEMENT</u>
	I.D. OF SURFACE CASING: <u>6"</u>
	TYPE OF SURFACE CASING: <u>STEEL</u>
	RISER PIPE I.D.: <u>4"</u>
	TYPE OF RISER PIPE: <u>SCH 40 PVC</u>
	BOREHOLE DIAMETER: <u>10 1/2"</u>
	TYPE OF BACKFILL: <u>CEMENT/BENTONITE GROUT</u>
	DEPTH TOP OF SEAL: <u>5.5'</u>
	TYPE OF SEAL: <u>BENTONITE PELLETS</u>
	DEPTH TOP OF SAND PACK: <u>6.5'</u>
	DEPTH TOP OF SCREEN: <u>7.5'</u>
TYPE OF SCREEN: <u>SCH 40 PVC</u>	
SLOT SIZE x LENGTH: <u>10 SLOT x 2.9 FT</u>	
I.D. OF SCREEN: <u>4"</u>	
TYPE OF SAND PACK: <u># 2 G-ROC</u>	
DEPTH BOTTOM OF SCREEN: <u>10.4'</u>	
DEPTH BOTTOM OF SAND PACK: <u>10.4'</u>	
TYPE OF BACKFILL BELOW OBSERVATION WELL: <u>BENTONITE PELLETS</u>	
ELEVATION / DEPTH OF HOLE: <u>AR001789 11.2'</u>	

MALCOLM
PIRNIE

OVERBURDEN
MONITORING WELL SHEET

ORIGINAL
(RED)

PROJECT MILLCREEK

PROJECT NO. 0285-23-1

ELEVATION 717.28

FIELD GEOLOGIST RN O'LASKEY

LOCATION EIRE, PA

BORING 27A

DATE 5-11-88


DRILLER EARL DYE

DRILLING

METHOD 6 1/4" TO AUGER

DEVELOPMENT

METHOD SURGE/BAIL/AIR

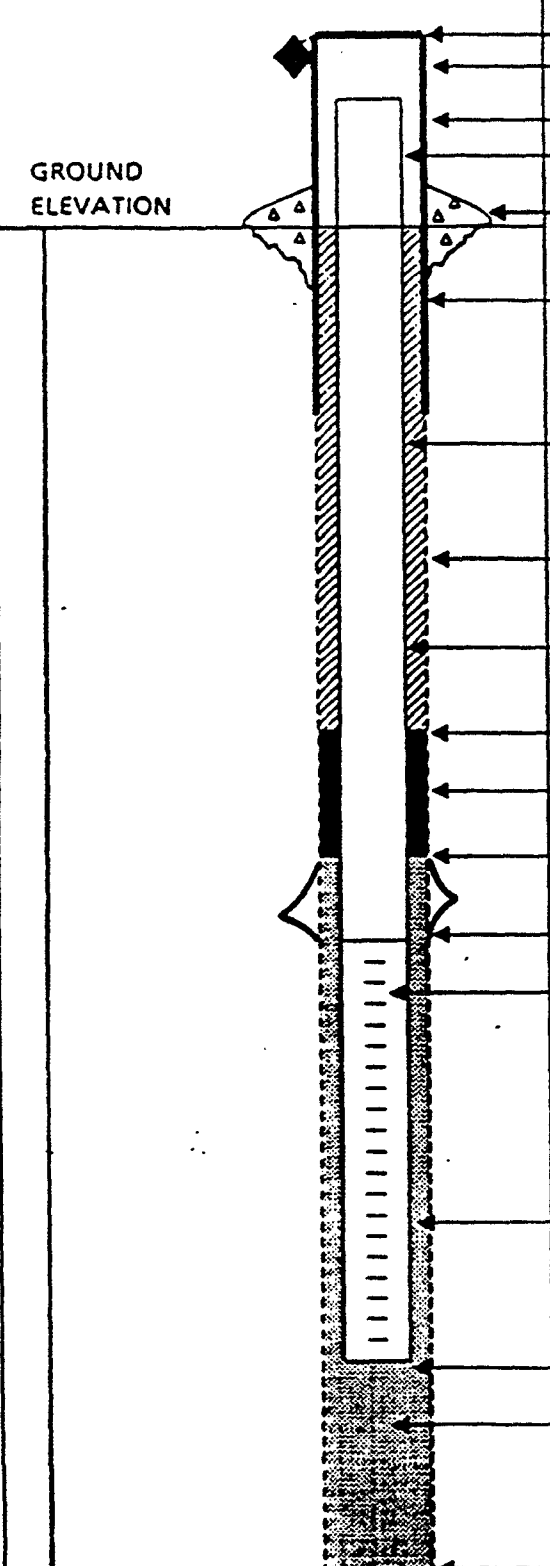	ELEVATION OF TOP OF SURFACE CASING :	<u>720.13</u>
	ELEVATION OF TOP OF RISER PIPE:	<u>719.58</u>
	STICK - UP TOP OF SURFACE CASING:	
	STICK - UP RISER PIPE :	<u>2.30'</u>
	TYPE OF SURFACE SEAL: <u>CEMENT</u>	
	I.D. OF SURFACE CASING: <u>6"</u>	
	TYPE OF SURFACE CASING: <u>STEEL</u>	
	RISER PIPE I.D. <u>4"</u>	
	TYPE OF RISER PIPE: <u>SCH 40 PVC</u>	
	BOREHOLE DIAMETER: <u>10 1/2"</u>	
	TYPE OF BACKFILL: <u>CEMENT/BENTONITE GROUT</u>	
	DEPTH TOP OF SEAL: <u>20.5'</u>	
	TYPE OF SEAL: <u>BENTONITE PELLETS</u>	
	DEPTH TOP OF SAND PACK: <u>22.8'</u>	
	<u>CENTRALIZER</u>	
DEPTH TOP OF SCREEN: <u>25.0'</u>		
TYPE OF SCREEN: <u>SCH 40 PVC</u>		
SLOT SIZE x LENGTH: <u>10 SLOT x 5 ft</u>		
I.D. OF SCREEN: <u>4"</u>		
TYPE OF SAND PACK: <u># 2 - G-ROC</u>		
DEPTH BOTTOM OF SCREEN: <u>30.0'</u>		
DEPTH BOTTOM OF SAND PACK: <u>36.0'</u>		
TYPE OF BACKFILL BELOW OBSERVATION WELL: <u>6' # 2 G-ROC</u>		
<u>4' CAVED FORMATION</u>		
ELEVATION / DEPTH OF HOLE: <u>AK001790 40.0'</u>		

MALCOLM
PIRNIE

OVERBURDEN
MONITORING WELL SHEET

PROJECT MILLCREEK

LOCATION FIRE PA

DRILLER EARL DYE

PROJECT NO. 0285-23-1

BORING 27B

DRILLING

ELEVATION 717.60

DATE 5-12-88

METHOD 6 1/4" JO AUGER

FIELD GEOLOGIST RH O'ASKBY

DEVELOPMENT

METHOD SURGE/BAIL/AIR

GROUND
ELEVATION

BOREHOLE
PARTIALLY
COLLAPSED
WHILE INSTALLING
PELLETS IN
OPEN HOLE

15 Bags
#2 G-ROC

Collapsed
SANDS AND
GRUBS

ELEVATION OF TOP OF SURFACE CASING : 720.05
ELEVATION OF TOP OF RISER PIPE: 719.65

STICK - UP TOP OF SURFACE CASING:
STICK - UP RISER PIPE: 2.05

TYPE OF SURFACE SEAL: CEMENT

I.D. OF SURFACE CASING: 6"
TYPE OF SURFACE CASING: STEEL

RISER PIPE I.D. 4"
TYPE OF RISER PIPE: SCH 40 PVC

BOREHOLE DIAMETER: 10 1/2"

TYPE OF BACKFILL: CEMENT/BENTONITE
GROUT

DEPTH TOP OF SEAL: 5' to 4'

TYPE OF SEAL: BENTONITE PELLETS

DEPTH TOP OF SAND PACK: 6.0'

DEPTH TOP OF SCREEN: 7.30'

TYPE OF SCREEN: SCH 40 PVC

SLOT SIZE x LENGTH: 10 SLOT x 5 1/2"

I.D. OF SCREEN: 4"

TYPE OF SAND PACK: #2 G-ROC
NOTE: 15.5 bags of sand pack
added from 10.2' to 6.0'.

DEPTH BOTTOM OF SCREEN: 12.3'

DEPTH BOTTOM OF SAND PACK: 10.2'

TYPE OF BACKFILL BELOW OBSERVATION
WELL: FORMATION CAVED FROM
10.2' to 15.5'

ELEVATION / DEPTH OF HOLE: AR0017915.5'

MALCOLM
PIRNIE

OVERBURDEN
MONITORING WELL SHEET

ORIGINAL
(RED)

PROJECT MILLCREEK

LOCATION PIRE, PA

DRILLER EARL DYE

PROJECT NO. 0285-23-1

BORING 28A

DRILLING

ELEVATION 713.64


DATE 5-4-88

METHOD 6 1/4" ID AUGER

FIELD GEOLOGIST R.H. OZASKEY

DEVELOPMENT

METHOD SURGE/BAIL/AIR

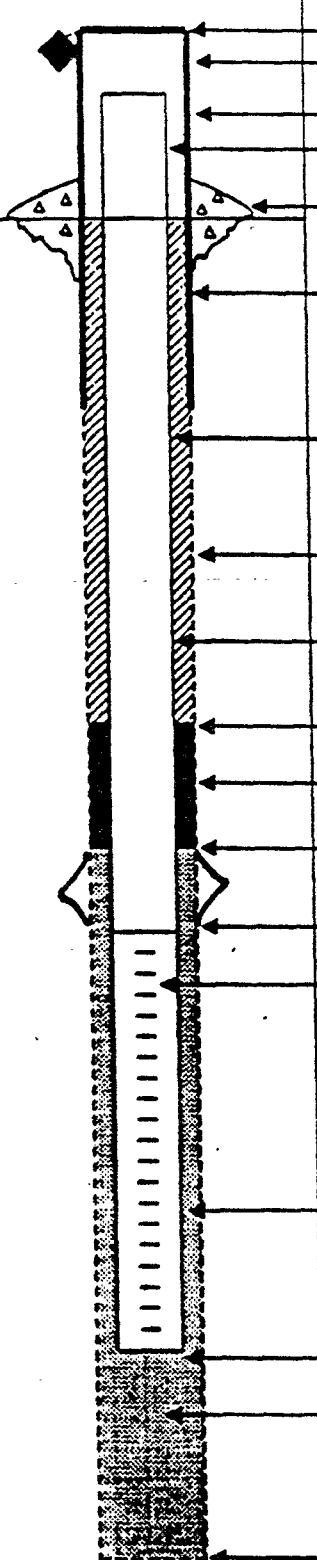
	ELEVATION OF TOP OF SURFACE CASING:	<u>715.69</u>
	ELEVATION OF TOP OF RISER PIPE:	<u>715.57</u>
	STICK - UP TOP OF SURFACE CASING:	
	STICK - UP RISER PIPE:	<u>1.93'</u>
	TYPE OF SURFACE SEAL:	<u>CEMENT</u>
	I.D. OF SURFACE CASING:	<u>6"</u>
	TYPE OF SURFACE CASING:	<u>STEEL</u>
	RISER PIPE I.D.:	<u>4"</u>
	TYPE OF RISER PIPE:	<u>SCH 40 PVC</u>
	BOREHOLE DIAMETER:	<u>10 1/2"</u>
	TYPE OF BACKFILL:	<u>CEMENT/BENTONITE GROUT</u>
	DEPTH TOP OF SEAL:	<u>31.5'</u>
	TYPE OF SEAL:	<u>BENTONITE PELLETS</u>
	DEPTH TOP OF SAND PACK:	<u>33.4'</u>
	CENTRALIZER	
DEPTH TOP OF SCREEN:	<u>35.6'</u>	
TYPE OF SCREEN:	<u>SCH 40 PVC</u>	
SLOT SIZE x LENGTH:	<u>10 SLOT x 10 ft</u>	
I.D. OF SCREEN:	<u>4"</u>	
TYPE OF SAND PACK:	<u># 2 G-ROC</u>	
DEPTH BOTTOM OF SCREEN:	<u>45.7'</u>	
DEPTH BOTTOM OF SAND PACK:	<u>43.4'</u>	
TYPE OF BACKFILL BELOW OBSERVATION WELL:	<u>FORMATION CAVED FROM</u>	
	<u>43.4 to 48.0</u>	
ELEVATION / DEPTH OF HOLE:	<u>AR001792</u> <u>48.0'</u>	

MALCOLM
PIRNIE

OVERBURDEN
MONITORING WELL SHEET

PROJECT MILLCREEK LOCATION 21RE PA
PROJECT NO. 0285-23-1 BORING 283
ELEVATION 713.51 DATE 5-5-88
FIELD GEOLOGIST RH O'ASKOY

DRILLER EARL DYE
DRILLING
METHOD 6 1/4" ID AUGER
DEVELOPMENT
METHOD SURGE/BAIL/AIR

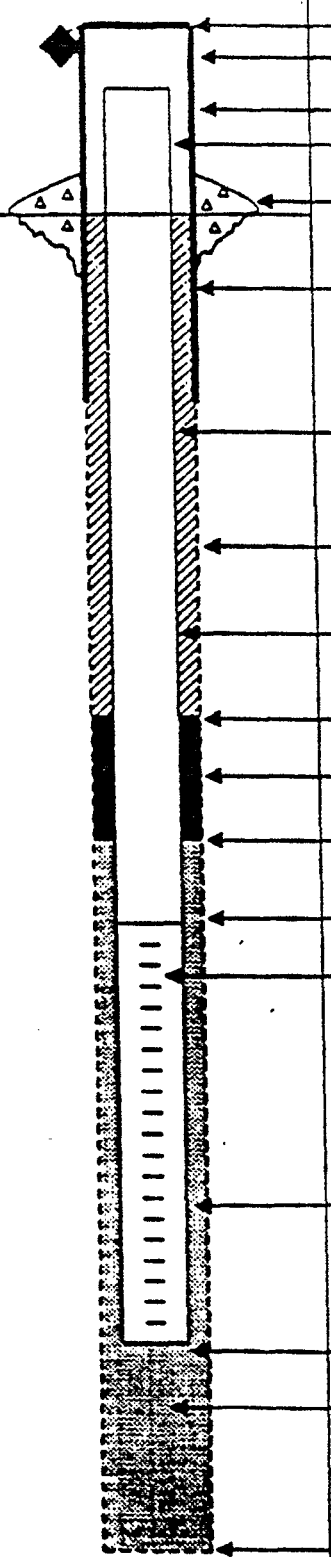	ELEVATION OF TOP OF SURFACE CASING :	<u>710.01</u>
	ELEVATION OF TOP OF RISER PIPE :	<u>715.70</u>
	STICK - UP TOP OF SURFACE CASING :	
	STICK - UP RISER PIPE :	<u>2.19'</u>
	TYPE OF SURFACE SEAL: <u>CEMENT</u>	
	I.D. OF SURFACE CASING: <u>6"</u>	
	TYPE OF SURFACE CASING: <u>STEEL</u>	
	RISER PIPE I.D. <u>4"</u>	
	TYPE OF RISER PIPE: <u>FLUSH JOINT SCH 40 PUC</u>	
	BOREHOLE DIAMETER: <u>10 1/2"</u>	
	TYPE OF BACKFILL: <u>CEMENT/BENTONITE GROUT</u>	
	DEPTH TOP OF SEAL: <u>4.0'</u>	
	TYPE OF SEAL: <u>BENTONITE PELLETS</u>	
	DEPTH TOP OF SAND PACK: <u>5.5'</u>	
	DEPTH TOP OF SCREEN: <u>7.0'</u>	
TYPE OF SCREEN: <u>Flush Joint Sch 40 PUC</u>		
SLOT SIZE x LENGTH: <u>10 SLOT x 5 ft</u>		
I.D. OF SCREEN: <u>4"</u>		
TYPE OF SAND PACK: <u>* 20-ROG</u>		
DEPTH BOTTOM OF SCREEN: <u>12.0'</u>		
DEPTH BOTTOM OF SAND PACK: <u>9.5'</u>		
TYPE OF BACKFILL BELOW OBSERVATION WELL: <u>FORMATION CAUSED FROM 9.5' to 13.0'</u>		
ELEVATION / DEPTH OF HOLE: <u>AR0017933.0'</u>		

MALCOLM
PIRNIE

OVERBURDEN
MONITORING WELL SHEET

ORIGINAL
(RED)

PROJECT <u>MILLCREEK</u>	LOCATION <u>FIRE PA</u>	DRILLER <u>EARL DYE</u>
PROJECT NO. <u>0285-23-1</u>	BORING <u>29</u>	DRILLING METHOD <u>6 1/4" ID AUGER</u>
ELEVATION <u>715.01</u>	DATE <u>5-17-88</u>	DEVELOPMENT METHOD <u>SURGE/BAIL/AIR</u>
FIELD GEOLOGIST <u>RH O'LASKEY</u>		

	ELEVATION OF TOP OF SURFACE CASING :	<u>715.01</u>
	ELEVATION OF TOP OF RISER PIPE :	<u>714.70</u>
	STICK - UP TOP OF SURFACE CASING :	
	STICK - UP RISER PIPE :	<u>-0.31'</u>
	TYPE OF SURFACE SEAL: <u>CEMENT</u>	
	I.D. OF SURFACE CASING: <u>8"</u>	
	TYPE OF SURFACE CASING: <u>AT GRADE STEEL WATER BOX</u>	
	RISER PIPE I.D. <u>4"</u>	
	TYPE OF RISER PIPE: <u>FLUSH THREAD SCH 40 PVC</u>	
	BOREHOLE DIAMETER: <u>10 1/2"</u>	
	TYPE OF BACKFILL: <u>CEMENT/BENTONITE GROUT</u>	
	DEPTH TOP OF SEAL: <u>6.0'</u>	
	TYPE OF SEAL: <u>BENTONITE PELLETS</u>	
	DEPTH TOP OF SAND PACK: <u>8.0'</u>	
	CENTRALIZER	
DEPTH TOP OF SCREEN: <u>10.5'</u>		
TYPE OF SCREEN: <u>FLUSH THREAD SCH 40 PVC</u>		
SLOT SIZE x LENGTH: <u>10 SLOT x 10 ft</u>		
I.D. OF SCREEN: <u>4"</u>		
TYPE OF SAND PACK: <u>#2 Q-ROC</u>		
DEPTH BOTTOM OF SCREEN: <u>20.5'</u>		
DEPTH BOTTOM OF SAND PACK: <u>20.0'</u>		
TYPE OF BACKFILL BELOW OBSERVATION WELL: <u>NONE</u>		
ELEVATION / DEPTH OF HOLE: <u>20.5'</u>		

AR001794

MALCOLM
PIRNIE

OVERBURDEN
MONITORING WELL SHEET

PROJECT MILLCREEK

PROJECT NO. 0285-23-1

ELEVATION 705.41

FIELD GEOLOGIST RH O'Laskey

LOCATION PIRE - PA

BORING 30

DATE 5-23-88

DRILLER EARL DYE


DRILLING

METHOD 6 1/4" ID AUGER

DEVELOPMENT

METHOD SURGE/BAIL/ AIR

GROUND
ELEVATION

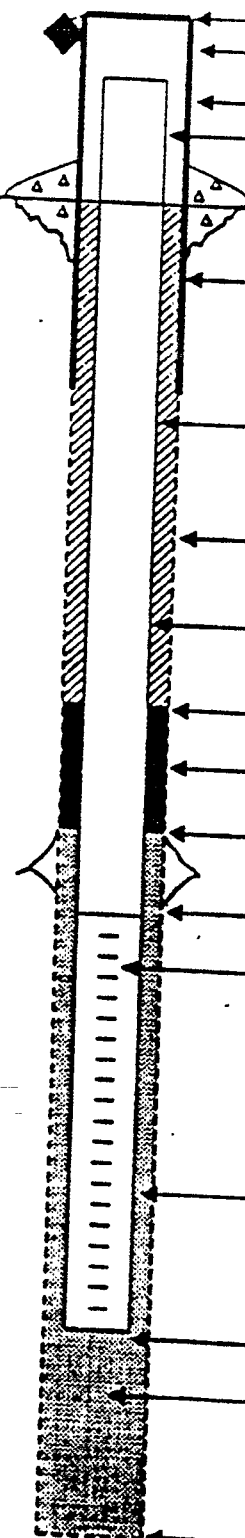

ELEVATION OF TOP OF SURFACE CASING :

ELEVATION OF TOP OF RISER PIPE:

705.41

705.11

STICK - UP TOP OF SURFACE CASING:

STICK - UP RISER PIPE :

- 0.30'

TYPE OF SURFACE SEAL: CEMENT

I.D. OF SURFACE CASING: 8"

TYPE OF SURFACE CASING:

AT GRADE STEEL WATER BOX

RISER PIPE I.D. 4"

TYPE OF RISER PIPE:

FLUSH THREAD SCH 40 PVC

BOREHOLE DIAMETER: 10 1/2"

TYPE OF BACKFILL: CEMENT/BENTONITE
GROUT

DEPTH TOP OF SEAL:

4.2'

TYPE OF SEAL: BENTONITE PELLETS

DEPTH TOP OF SAND PACK:

6.0'

CENTRALIZER

DEPTH TOP OF SCREEN:

10.5'

TYPE OF SCREEN: FLUSH THREAD SCH 40 PVC

SLOT SIZE x LENGTH: 10 SLOT x 10 ft

I.D. OF SCREEN: 4"

TYPE OF SAND PACK: PREDOMINANTLY
COLLAPSED SANDS AND GRAVELS
FROM FORMATION WITH MINOR
M & Q-RDC.

DEPTH BOTTOM OF SCREEN:

20.5'

DEPTH BOTTOM OF SAND PACK:

TYPE OF BACKFILL BELOW OBSERVATION
WELL: NONE

ELEVATION / DEPTH OF HOLE:

AR001795 20.5'

**MALCOLM
PIRNIE**

**OVERBURDEN
MONITORING WELL SHEET**

(RED)

PROJECT <u>MILLCREEK</u>	LOCATION <u>EIRE, PA</u>	DRILLER <u>EARL DYE</u>
PROJECT NO. <u>0285-23-1</u>	BORING <u>31</u>	DRILLING METHOD <u>6 1/4" ID AUGER</u>
ELEVATION <u>711.50</u>	DATE <u>5-18-88</u>	DEVELOPMENT METHOD <u>SURGE/BAIL/ AIR</u>
FIELD GEOLOGIST <u>RH O'LEARY</u>		


	ELEVATION OF TOP OF SURFACE CASING :	<u>711.50</u>
	ELEVATION OF TOP OF RISER PIPE :	<u>711.20</u>
	STICK - UP TOP OF SURFACE CASING :	
	STICK - UP RISER PIPE :	<u>-0.30'</u>
	TYPE OF SURFACE SEAL: <u>CEMENT</u>	
	I.D. OF SURFACE CASING: <u>8"</u>	
	TYPE OF SURFACE CASING: <u>AT GRADE STEEL WATER BOX</u>	
	RISER PIPE I.D. <u>4"</u>	
	TYPE OF RISER PIPE: <u>FLUSH THREAD SCH 40 PVC</u>	
	BOREHOLE DIAMETER: <u>10 1/2"</u>	
	TYPE OF BACKFILL: <u>CEMENT/BENTONITE GROUT</u>	
	DEPTH TOP OF SEAL:	<u>4.5'</u>
	TYPE OF SEAL: <u>BENTONITE PELLETS</u>	
	DEPTH TOP OF SAND PACK:	<u>6.0'</u>
	CENTRALIZER	
DEPTH TOP OF SCREEN:	<u>9.4'</u>	
TYPE OF SCREEN: <u>FLUSH THREAD SCH 40 PVC</u>		
SLOT SIZE x LENGTH: <u>10 SLOT x 10 ft</u>		
I.D. OF SCREEN: <u>4"</u>		
TYPE OF SAND PACK: <u>FORMATION ALLOWED TO COLLAPSE FROM 25.0' TO 6.0'</u>		
DEPTH BOTTOM OF SCREEN:	<u>19.4'</u>	
DEPTH BOTTOM OF SAND PACK:	<u>-</u>	
TYPE OF BACKFILL BELOW OBSERVATION WELL: <u>MEDIUM SANDS FROM FORMATION</u>		
ELEVATION / DEPTH OF HOLE	<u>AR001796 25.0'</u>	

ORIGINAL
(RED)

MALCOLM
PIRNIE

OVERBURDEN MONITORING WELL SHEET

PROJECT MILLCREEK LOCATION ELRE, PA DRILLER EARL DYLE
PROJECT NO. 0285-23-1 BORING 32 DRILLING
ELEVATION 711.41 DATE 5-25-88 METHOD 6 1/4" ID AUGER
FIELD GEOLOGIST RA O'LASKEY DEVELOPMENT
METHOD SURGE/RAIL/AIR

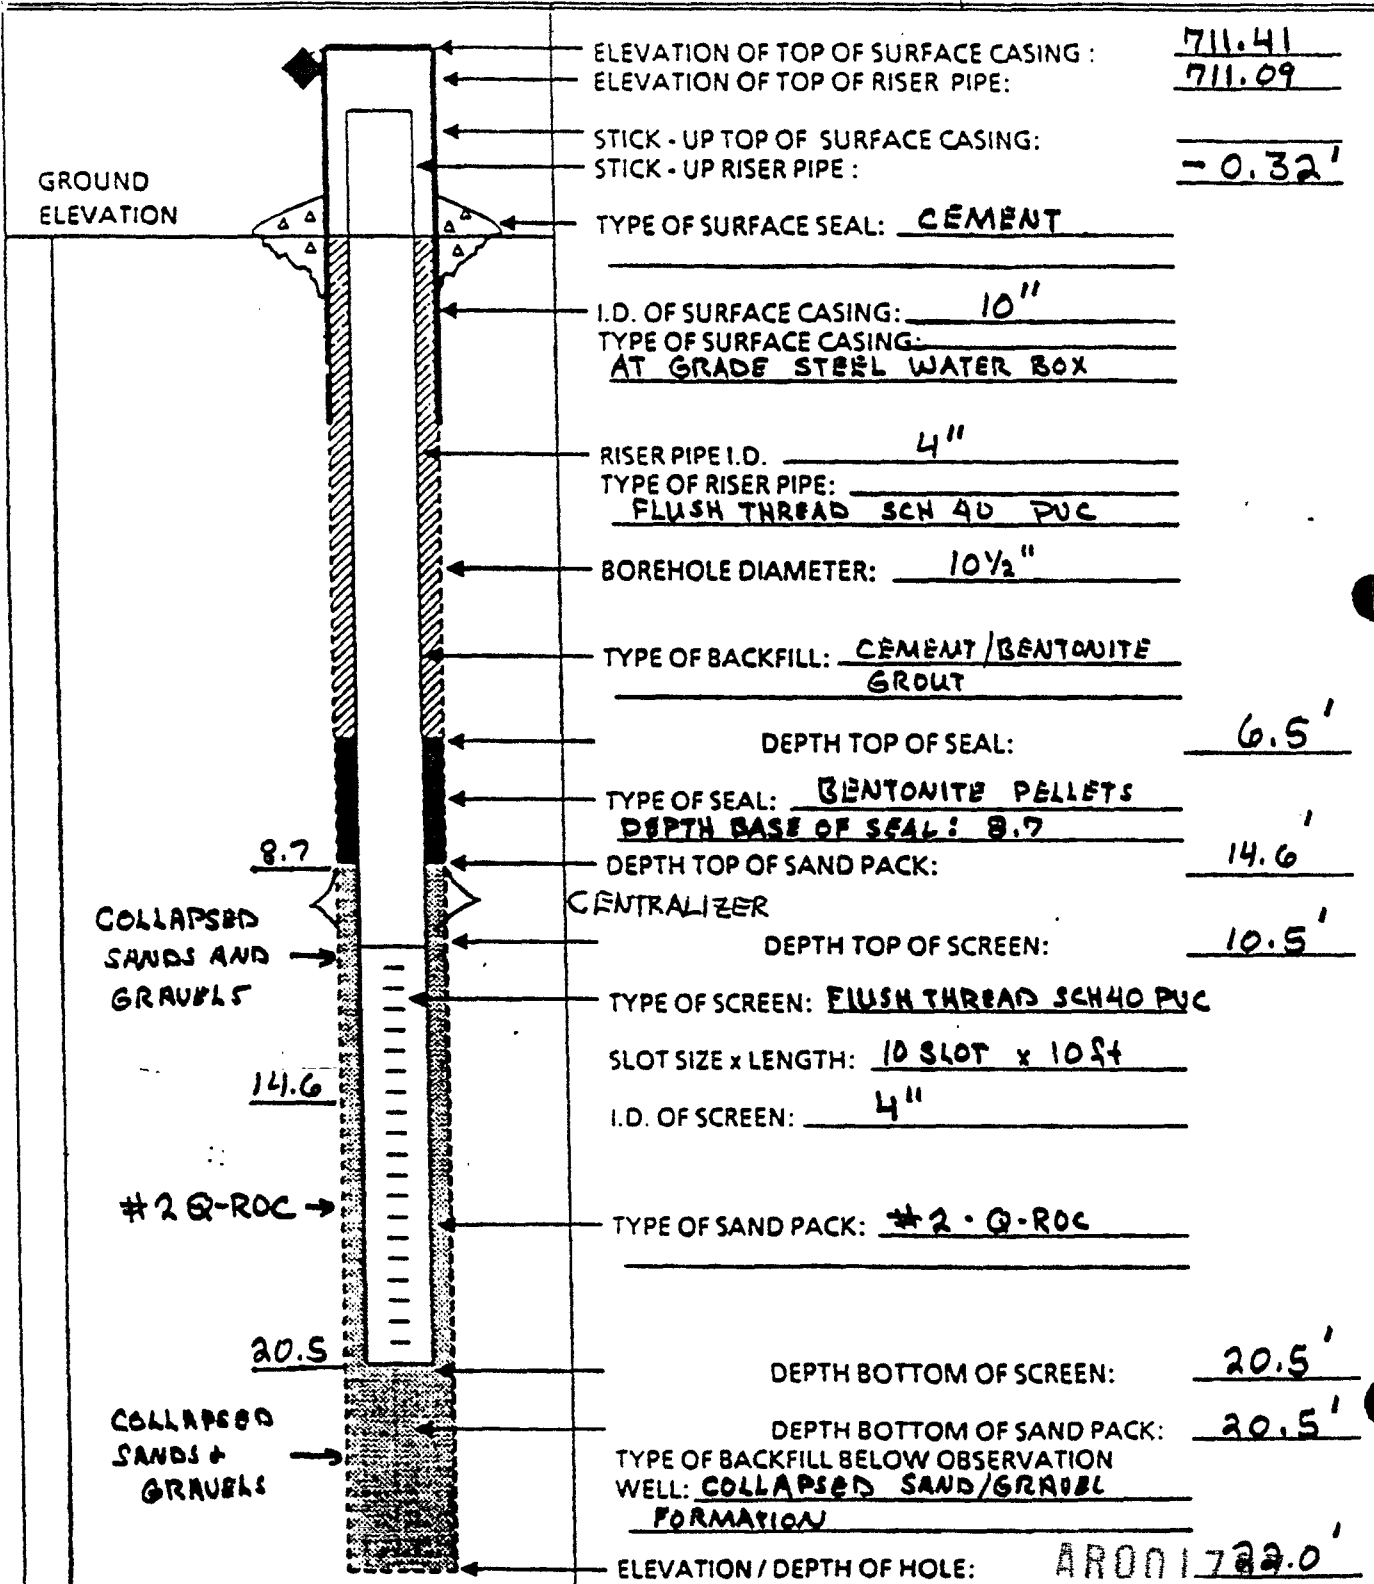

AR001797

MALCOLM
PIRNIE

OVERBURDEN
MONITORING WELL SHEET

COPIED
(RED)

PROJECT MILL CREEK

LOCATION EIRE, PA

DRILLER EARL DYE

PROJECT NO. 0285-23-1

BORING 33A

DRILLING

ELEVATION 715.52


DATE 4-27-88

METHOD 6 1/4" ID AUGER

FIELD GEOLOGIST RH OLASKY

DEVELOPMENT

METHOD SURGE/BAIL/ AIR

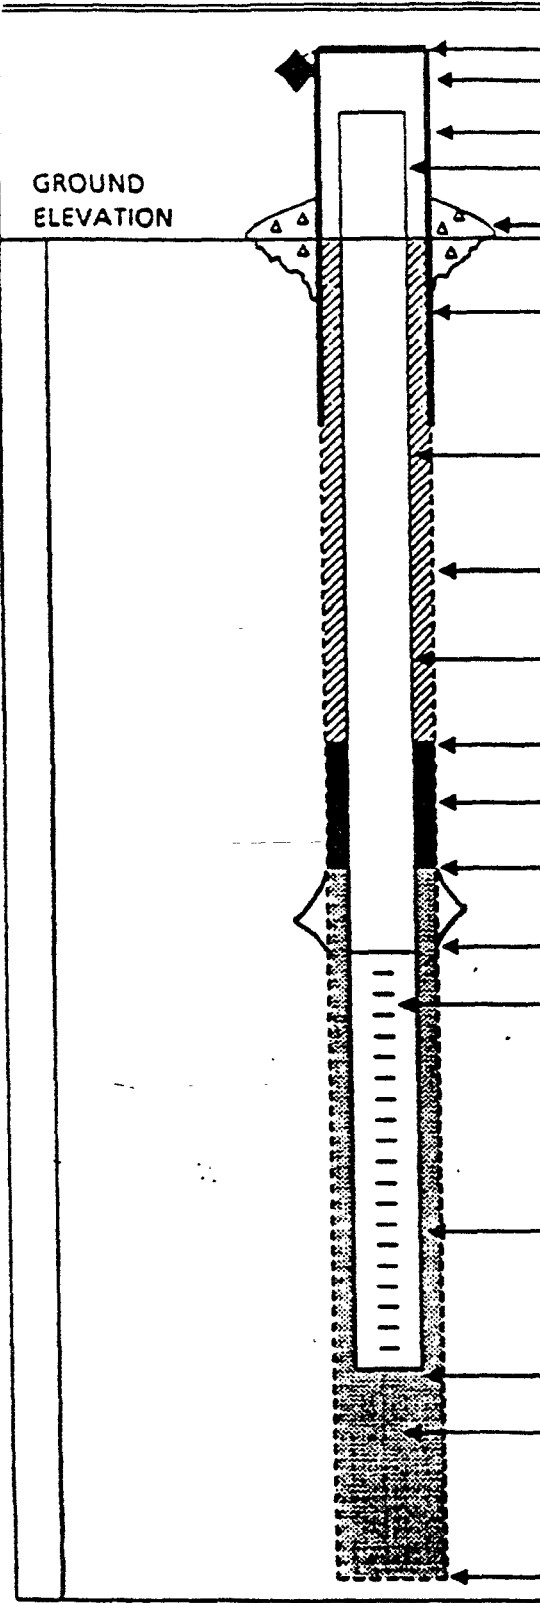	ELEVATION OF TOP OF SURFACE CASING :	<u>718.02</u>
	ELEVATION OF TOP OF RISER PIPE:	<u>719.68</u>
	STICK - UP TOP OF SURFACE CASING:	
	STICK - UP RISER PIPE :	<u>2.16'</u>
	TYPE OF SURFACE SEAL: <u>CEMENT</u>	
	I.D. OF SURFACE CASING: <u>6"</u>	
	TYPE OF SURFACE CASING: <u>STEEL</u>	
	RISER PIPE I.D. <u>4"</u>	
	TYPE OF RISER PIPE: <u>FLUSH THREAD SCH 40 PVC</u>	
	BOREHOLE DIAMETER: <u>10 1/2"</u>	
	TYPE OF BACKFILL: <u>CEMENT/BENTONITE GROUT</u>	
	DEPTH TOP OF SEAL:	<u>27.0'</u>
	TYPE OF SEAL: <u>BENTONITE PELLETS</u>	
	DEPTH TOP OF SAND PACK:	<u>28.5'</u>
	CENTRALIZER	
DEPTH TOP OF SCREEN:	<u>31.2'</u>	
TYPE OF SCREEN: <u>FLUSH JOINT SCH 40 PVC</u>		
SLOT SIZE x LENGTH: <u>10 SLOT x 10 ft</u>		
I.D. OF SCREEN: <u>4"</u>		
TYPE OF SAND PACK: <u># 2 G-ROCK</u>		
DEPTH BOTTOM OF SCREEN:	<u>41.2'</u>	
DEPTH BOTTOM OF SAND PACK:	<u>42.2'</u>	
TYPE OF BACKFILL BELOW OBSERVATION WELL: <u>COLLAPSED FORMATION</u>		
FROM <u>42.4' to 44.0'</u>		
ELEVATION / DEPTH OF HOLE	<u>44.0'</u>	

NR001798


**MALCOLM
PIRNIE**

**OVERBURDEN
MONITORING WELL SHEET**

PROJECT MILLCREEK LOCATION EIRE PA
PROJECT NO. 0285-23-1 BORING 33B
ELEVATION 715.55 DATE 5-12-88
FIELD GEOLOGIST T. MURTAUGH

DRILLER BERNIE GOLLIHUE
DRILLING
METHOD 6 1/4" ID AUGER
DEVELOPMENT
METHOD SURGE/BAIL/AIR

GROUND
ELEVATION

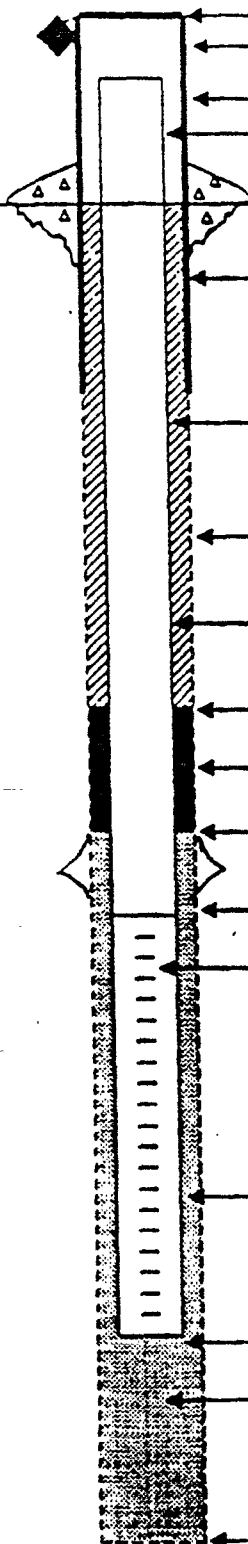

ELEVATION OF TOP OF SURFACE CASING: 717.81
ELEVATION OF TOP OF RISER PIPE: 717.57

STICK - UP TOP OF SURFACE CASING: _____
STICK - UP RISER PIPE: 2.11'

TYPE OF SURFACE SEAL: CEMENT

I.D. OF SURFACE CASING: 6"
TYPE OF SURFACE CASING: STEEL

RISER PIPE I.D.: 4"
TYPE OF RISER PIPE: FLUSH THREAD SCH 40 PVC

BOREHOLE DIAMETER: 10 1/2"

TYPE OF BACKFILL: CEMENT/BENTONITE
GROUT

DEPTH TOP OF SEAL: 7.0'

TYPE OF SEAL: BENTONITE PELLETS

DEPTH TOP OF SAND PACK: 8.7'

CENTRALIZER
DEPTH TOP OF SCREEN: 11.0'

TYPE OF SCREEN: FLUSH THREAD SCH 40 PVC

SLOT SIZE x LENGTH: 10 SLOT x 5 ft

I.D. OF SCREEN: 4"

TYPE OF SAND PACK: #2 G-ROC
AND FORMATION SAND

DEPTH BOTTOM OF SCREEN: 16.0'

DEPTH BOTTOM OF SAND PACK: 17.0'

TYPE OF BACKFILL BELOW OBSERVATION
WELL: FORMATION SAND
AND #2 G-ROC

ELEVATION / DEPTH OF HOLE: AR001799 17'

MALCOLM
PIRNIE


OVERBURDEN
MONITORING WELL SHEET

ORIGINAL
(RED)

PROJECT MILLCREEK
PROJECT NO. 0285-23-1
ELEVATION 717.64
FIELD GEOLOGIST RH O'KASKEY

LOCATION EIRE, PA
BORING 34
DATE 5-13-88

DRILLER EARL DYE
DRILLING
METHOD 6 1/4" ID AUGER
DEVELOPMENT
METHOD SURGE/BAIL/AIR

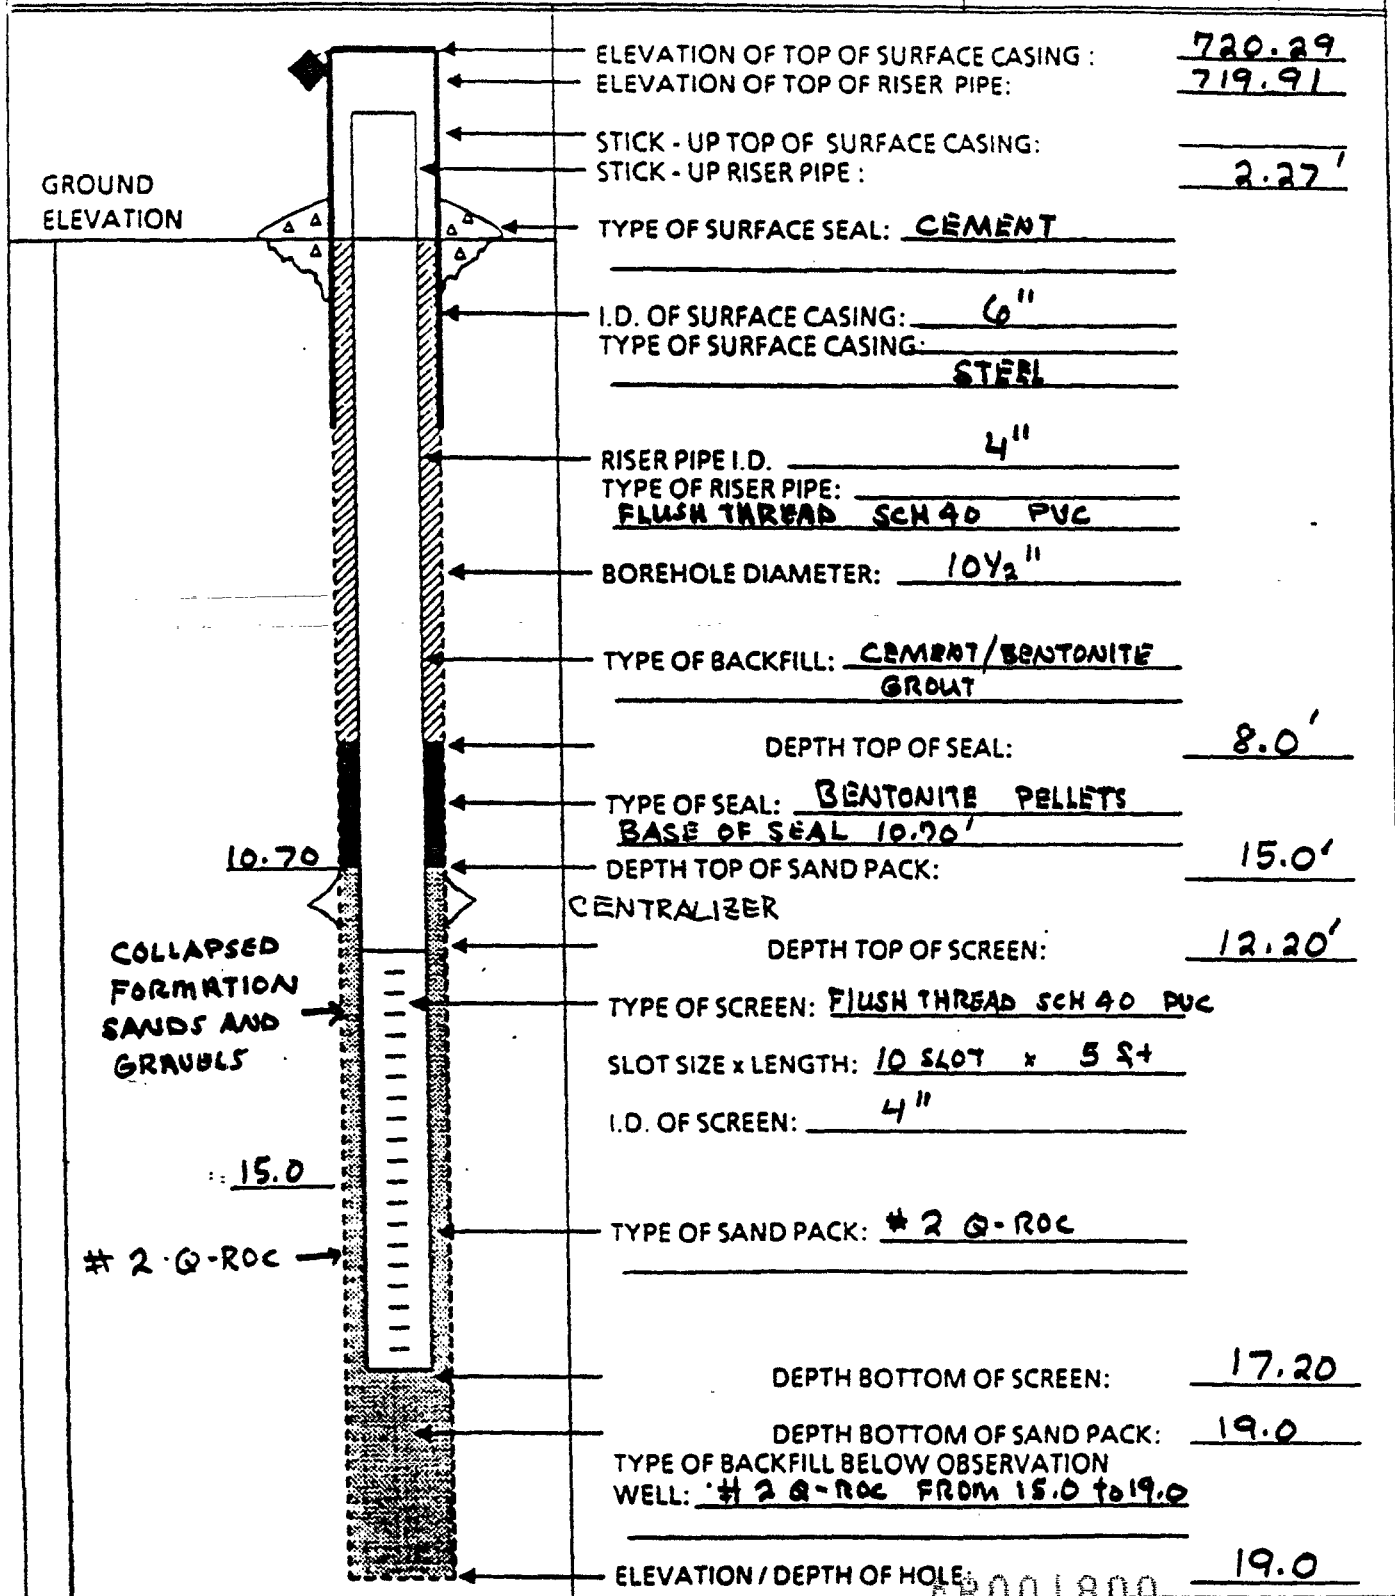


MALCOLM
PIRNIE

OVERBURDEN
MONITORING WELL SHEET

PROJECT MILLCREEK
PROJECT NO. 0285-23-1
ELEVATION 711.30
FIELD GEOLOGIST RH O'LASKEY

LOCATION FIRE PA
BORING 35
DATE 5-24-88

DRILLER EARL DYE
DRILLING
METHOD 6 1/4" ID AUGER
DEVELOPMENT
METHOD SURGE/BAIL/AIR

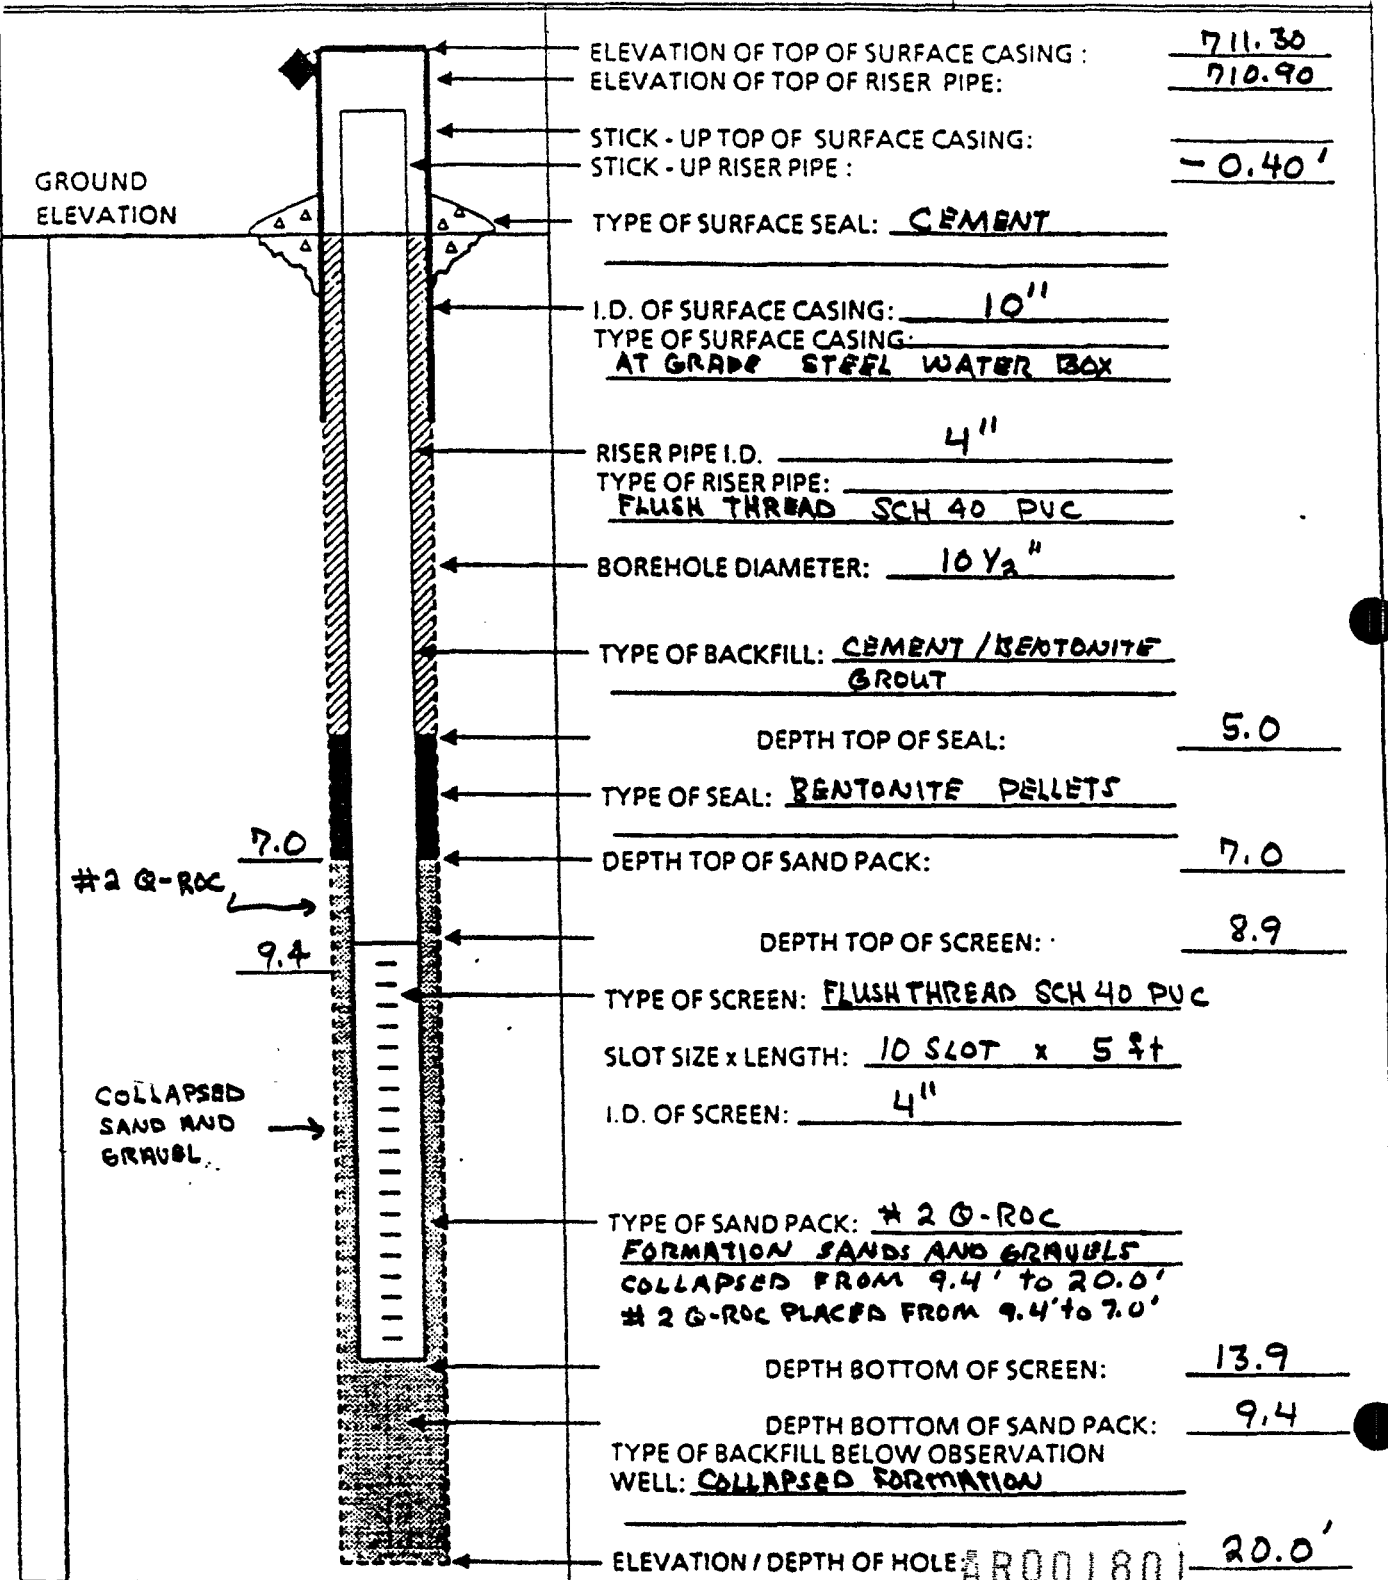


**MALCOLM
PIRNIE**

**OVERBURDEN
MONITORING WELL SHEET**

PROJECT MILLCREEK LOCATION PIRE, PA
PROJECT NO. 0285-23-1 BORING 36
ELEVATION _____ DATE 6-8-88
FIELD GEOLOGIST RH O'LASKEY

DRILLER EARL DYE
DRILLING
METHOD 6 1/4" ID AUGER
DEVELOPMENT
METHOD NONE

GROUND
ELEVATION

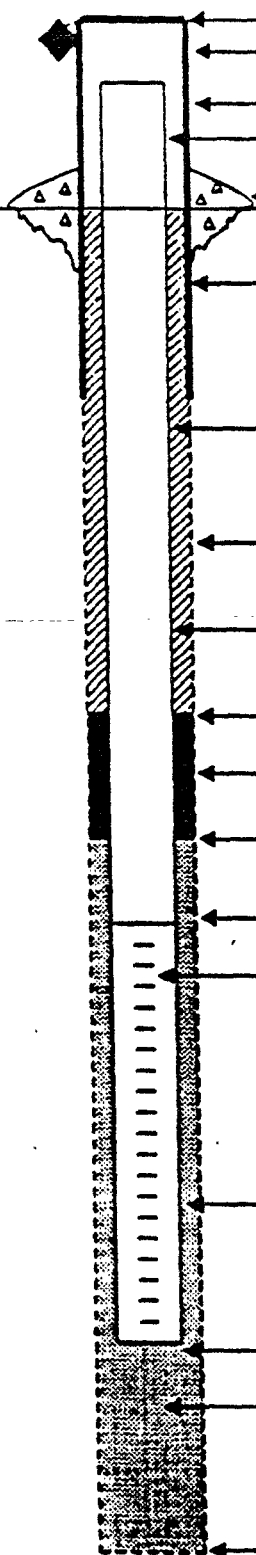

ELEVATION OF TOP OF SURFACE CASING: 729.00
ELEVATION OF TOP OF RISER PIPE: 728.62

STICK - UP TOP OF SURFACE CASING: ~2.6'
STICK - UP RISER PIPE: ~2.2'

TYPE OF SURFACE SEAL: CEMENT

I.D. OF SURFACE CASING: 6"
TYPE OF SURFACE CASING: STEEL

RISER PIPE I.D.: 4"
TYPE OF RISER PIPE: FLUSH THREAD SCH 40 PVC

BOREHOLE DIAMETER: 10 1/2"

TYPE OF BACKFILL: CEMENT/BENTONITE
GROUT

DEPTH TOP OF SEAL: 5.3

TYPE OF SEAL: BENTONITE PELLETS

DEPTH TOP OF SAND PACK: 7.0

DEPTH TOP OF SCREEN: 8.0

TYPE OF SCREEN: FLUSH THREAD SCH 40 PVC

SLOT SIZE x LENGTH: 10 SLOT x 5 ft

I.D. OF SCREEN: 4"

TYPE OF SAND PACK: #2 G-ROC

DEPTH BOTTOM OF SCREEN: 13.0

DEPTH BOTTOM OF SAND PACK: 13.0

TYPE OF BACKFILL BELOW OBSERVATION
WELL: BENTONITE PELLETS

ELEVATION / DEPTH OF HOLE: 6R001802 13.7

HYDRAULIC CONDUCTIVITY DATA
AND
CALCULATIONS

0285-23-1

AR001803

BY RHO DATE 2-29-85 SHEET NO. _____ OF _____
CHKD. BY _____ DATE _____ JOB NO. _____
SUBJECT MILL CREEK

JRS:JRS
(RED)OW-1 6-29-83


$$r_c = 1'' = .0833'$$
$$L = 42.00 - 8.00 = 34.00$$

$$R = 6 \text{ in} = 0.5'$$

$$h_1 = .70 \quad t_1 = 30 \text{ sec}$$
$$h_2 = .20 \quad t_2 = 135 \text{ sec}$$

$$K = \frac{(r_c)^2 \ln L/R}{2 L (t_2 - t_1)} \cdot \ln \frac{h_1}{h_2}$$
$$= \frac{(.0833)^2 (\ln 34.00/.5)}{2 (34.00) (135 - 30 \text{ sec})} \cdot \ln \frac{.70}{.20} = 5.137 \times 10^{-6} \frac{\text{ft}}{\text{sec}}$$

$$\times \frac{12 \text{ in}}{\text{ft}} \times \frac{2.54 \text{ cm}}{\text{in}} = 1.6 \times 10^{-4} \text{ cm/sec}$$

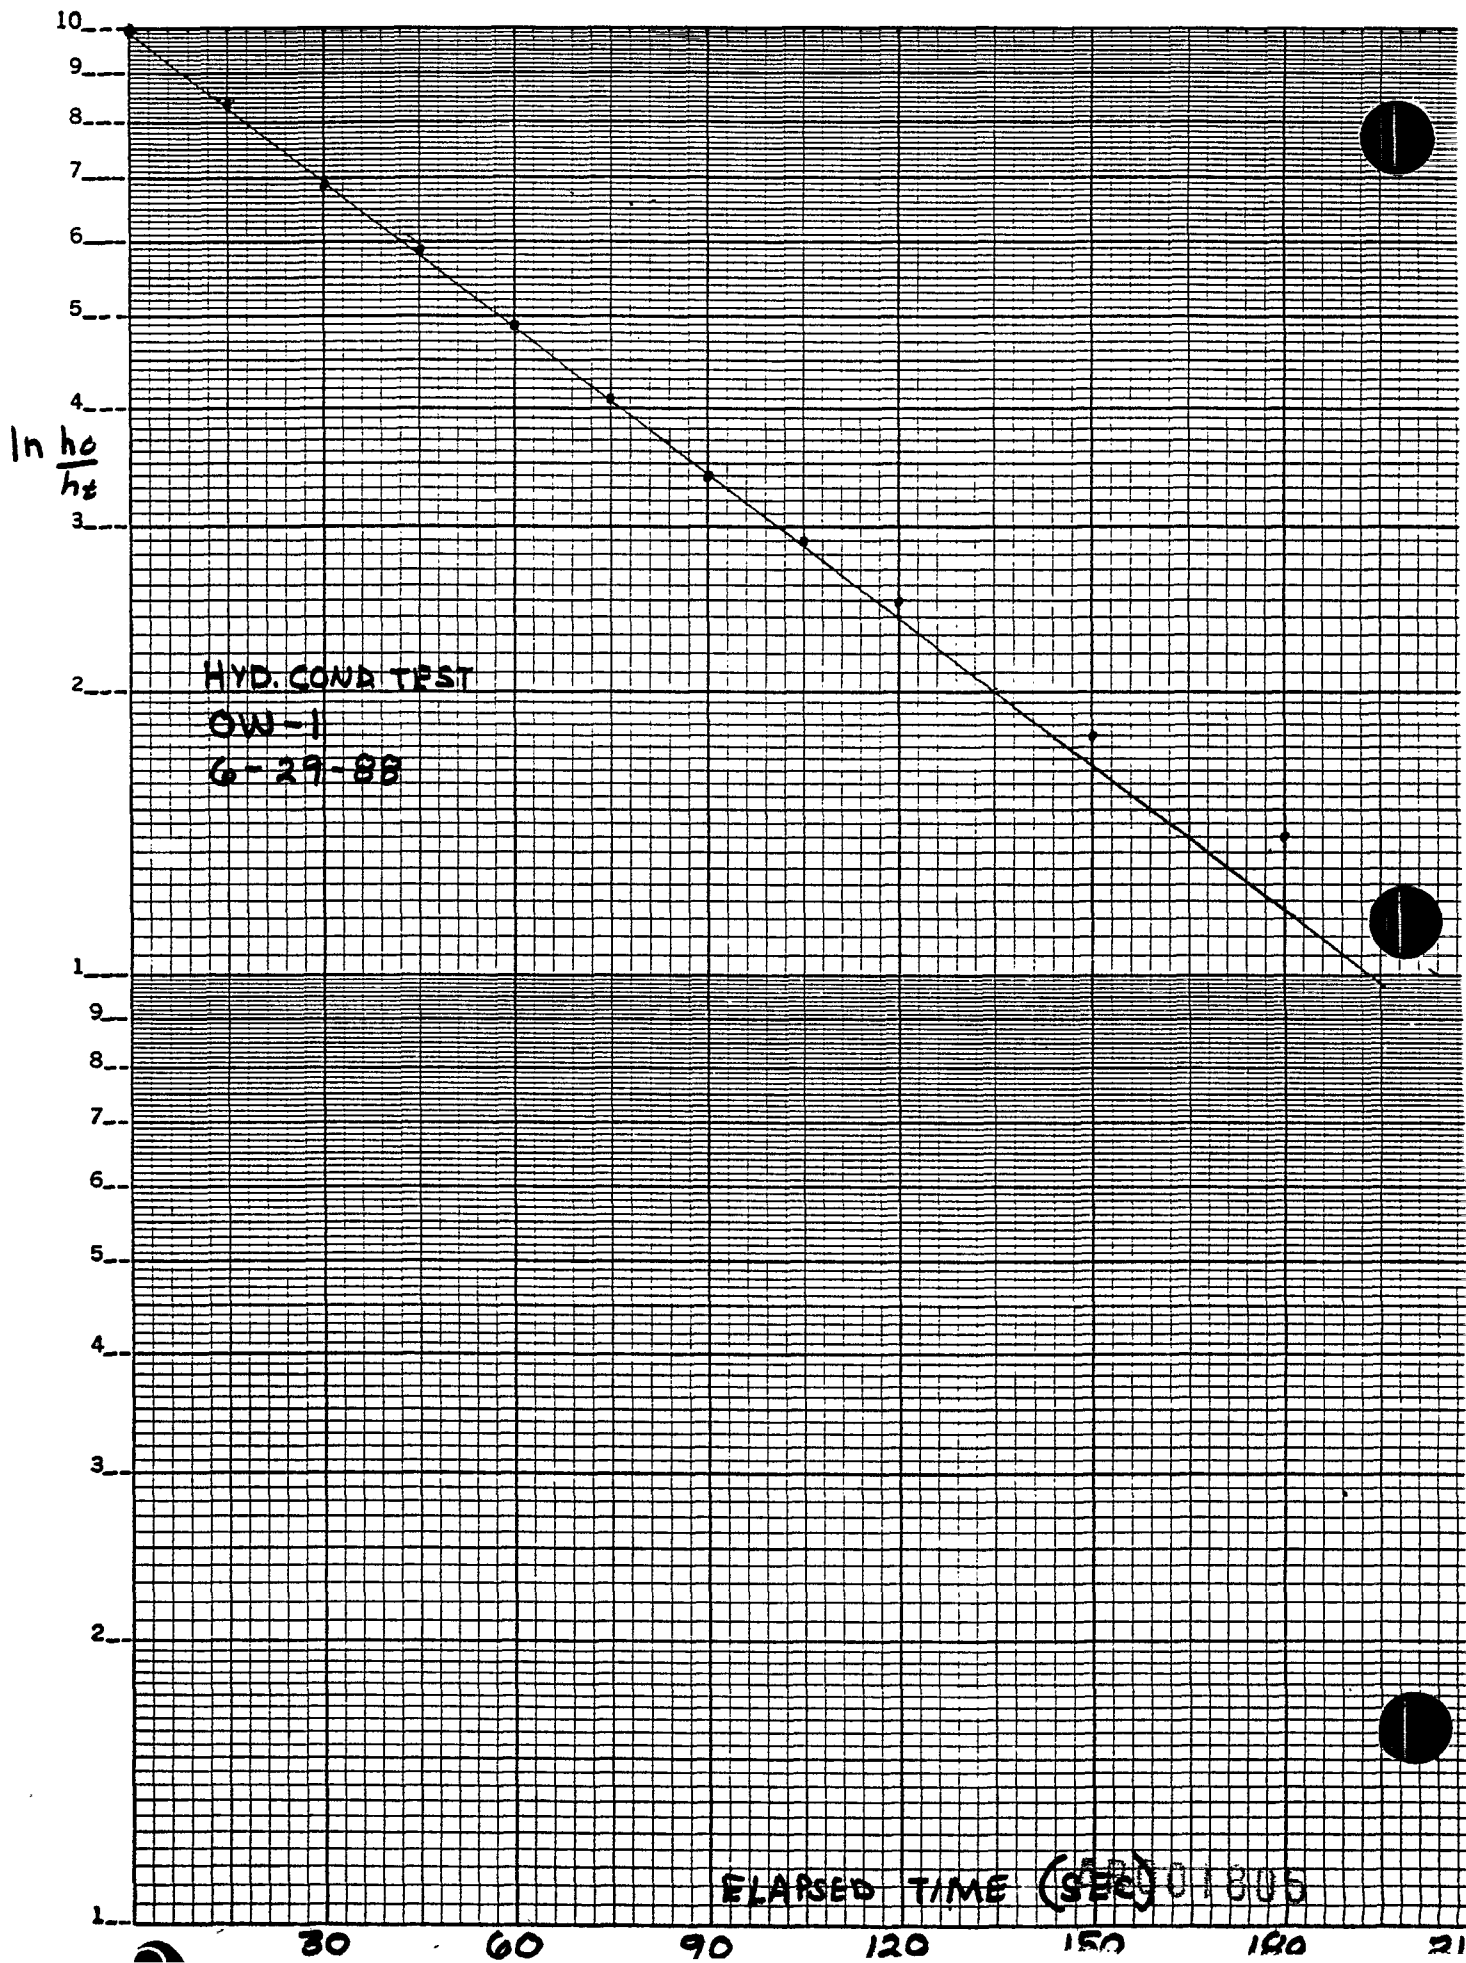

FIELD DATA SHEET

IN-SITU HYDRAULIC CONDUCTIVITY TEST

PROJECT NUMBER AND CLIENT NAME 0285-23-1 COE		LOCATION MILLCREEK	DATE OF TEST 6-27-99	WELL NUMBER OW-1	
TEST TYPE Rising Head	TEST METHOD (EQUIP.) Pump to limit of Centrifugal Pump - see M-Scope		INITIAL WATER LEVEL BELOW REF. l_i (ft.) 8.39 TOP OF STEEL	TESTED BY: RHU/DSD	
CLOCK TIME	ELAPSED TIME (t) Units: <u>SEC</u>	WATER LEVEL BELOW REF. AT TIME $t(l_t)$ (Ft)	HEAD AT TIME $t(h_t)$ $h_t = l_t - l_i$	HEAD RATIO h_t/h_o	REMARKS
11:15:00	0	23.8	15.41	1.0	
:15	15	21.4	13.01	.84	
:30	30	19.0	10.61	.69	
:45	45	17.43	9.04	.59	
11:16:00	60	16.00	7.61	.49	
:15	75	14.73	6.34	.41	
:30	90	13.67	5.28	.34	
:45	105	12.70	4.51	.29	
11:17:00	120	12.22	3.83	.25	
:30	150	11.22	2.83	.18	
:45	165	10.79			
11:18:00	180	10.49	2.10	.14	
:15	195	10.21			
:30	210	9.98	1.59	.10	
:45	225	9.78			
11:19:00	240	9.60	1.14	.07	
:15	255	9.46			
:30	270	9.33	0.94	.06	
:45	285	9.23			
11:20:00	300	9.13	0.74	.05	
:15		9.08			
:30		8.98			
:45		8.91			
11:21:00		8.85			

ARD01806

FIELD DATA SHEET

IN-SITU HYDRAULIC CONDUCTIVITY TEST

PROJECT NUMBER AND CLIENT NAME		LOCATION	DATE OF TEST	WELL NUMBER	
TEST TYPE	TEST METHOD (EQUIP.)		INITIAL WATER LEVEL BELOW REF. l_i (ft.)	TESTED BY:	
CLOCK TIME	ELAPSED TIME (t) Units: <u> </u>	WATER LEVEL BELOW REF. AT TIME $t(l_t)$ (Ft)	HEAD AT TIME $t(h_t)$ $h_t = l_t - l_i$	HEAD RATIO h_t/h_o	REMARKS
11:21:15		8.80			
1:30		8.76			
11:22:00		8.69			
11:23:00		8.58			
AR001807					


OW-1 6-29-33

$$\begin{aligned}
 H &= 42.00 + 2.36 - 8.39 = 35.97 \\
 D &= \dots = H \\
 L &= 42.00 - 8.2 = 33.80, \quad h/rw = \frac{38.80}{.5} \\
 r_c &= 1 \text{ in} = .0833' \\
 rw &= 6 \text{ in} = .5' \quad = 67.60 \\
 & \quad C = 3.25 \\
 t &= \dots = 120 \text{ sec} \\
 y_0 &= \dots = 15.41 \\
 y_t &= \dots = 3.83
 \end{aligned}$$

$$\begin{aligned}
 \ln R_e/rw &= \left(\frac{1.1}{\ln H/rw} + \frac{C}{L/rw} \right)^{-1} \\
 &= \left(\frac{1.1}{4.2758} + \frac{3.25}{67.60} \right)^{-1} \\
 &= (0.2339 + 0.0481) = 3.5464
 \end{aligned}$$

$$\begin{aligned}
 K &= \frac{r_c^2}{2L} \ln R_e/rw \cdot \frac{1}{t} \cdot \ln \frac{y_0}{y_t} \\
 &= \frac{(.0833)^2 (3.5464)}{2 (33.80)} \cdot \frac{1}{120 \text{ sec}} \cdot \ln \frac{15.41}{3.83} = 4.223 \times 10^{-6} \frac{\text{ft}}{\text{sec}} \\
 &\quad \times \frac{12 \text{ in}}{\text{ft}} \times \frac{2.54 \text{ cm}}{\text{in}} = 1.3 \times 10^{-4} \text{ cm/sec}
 \end{aligned}$$

ln y

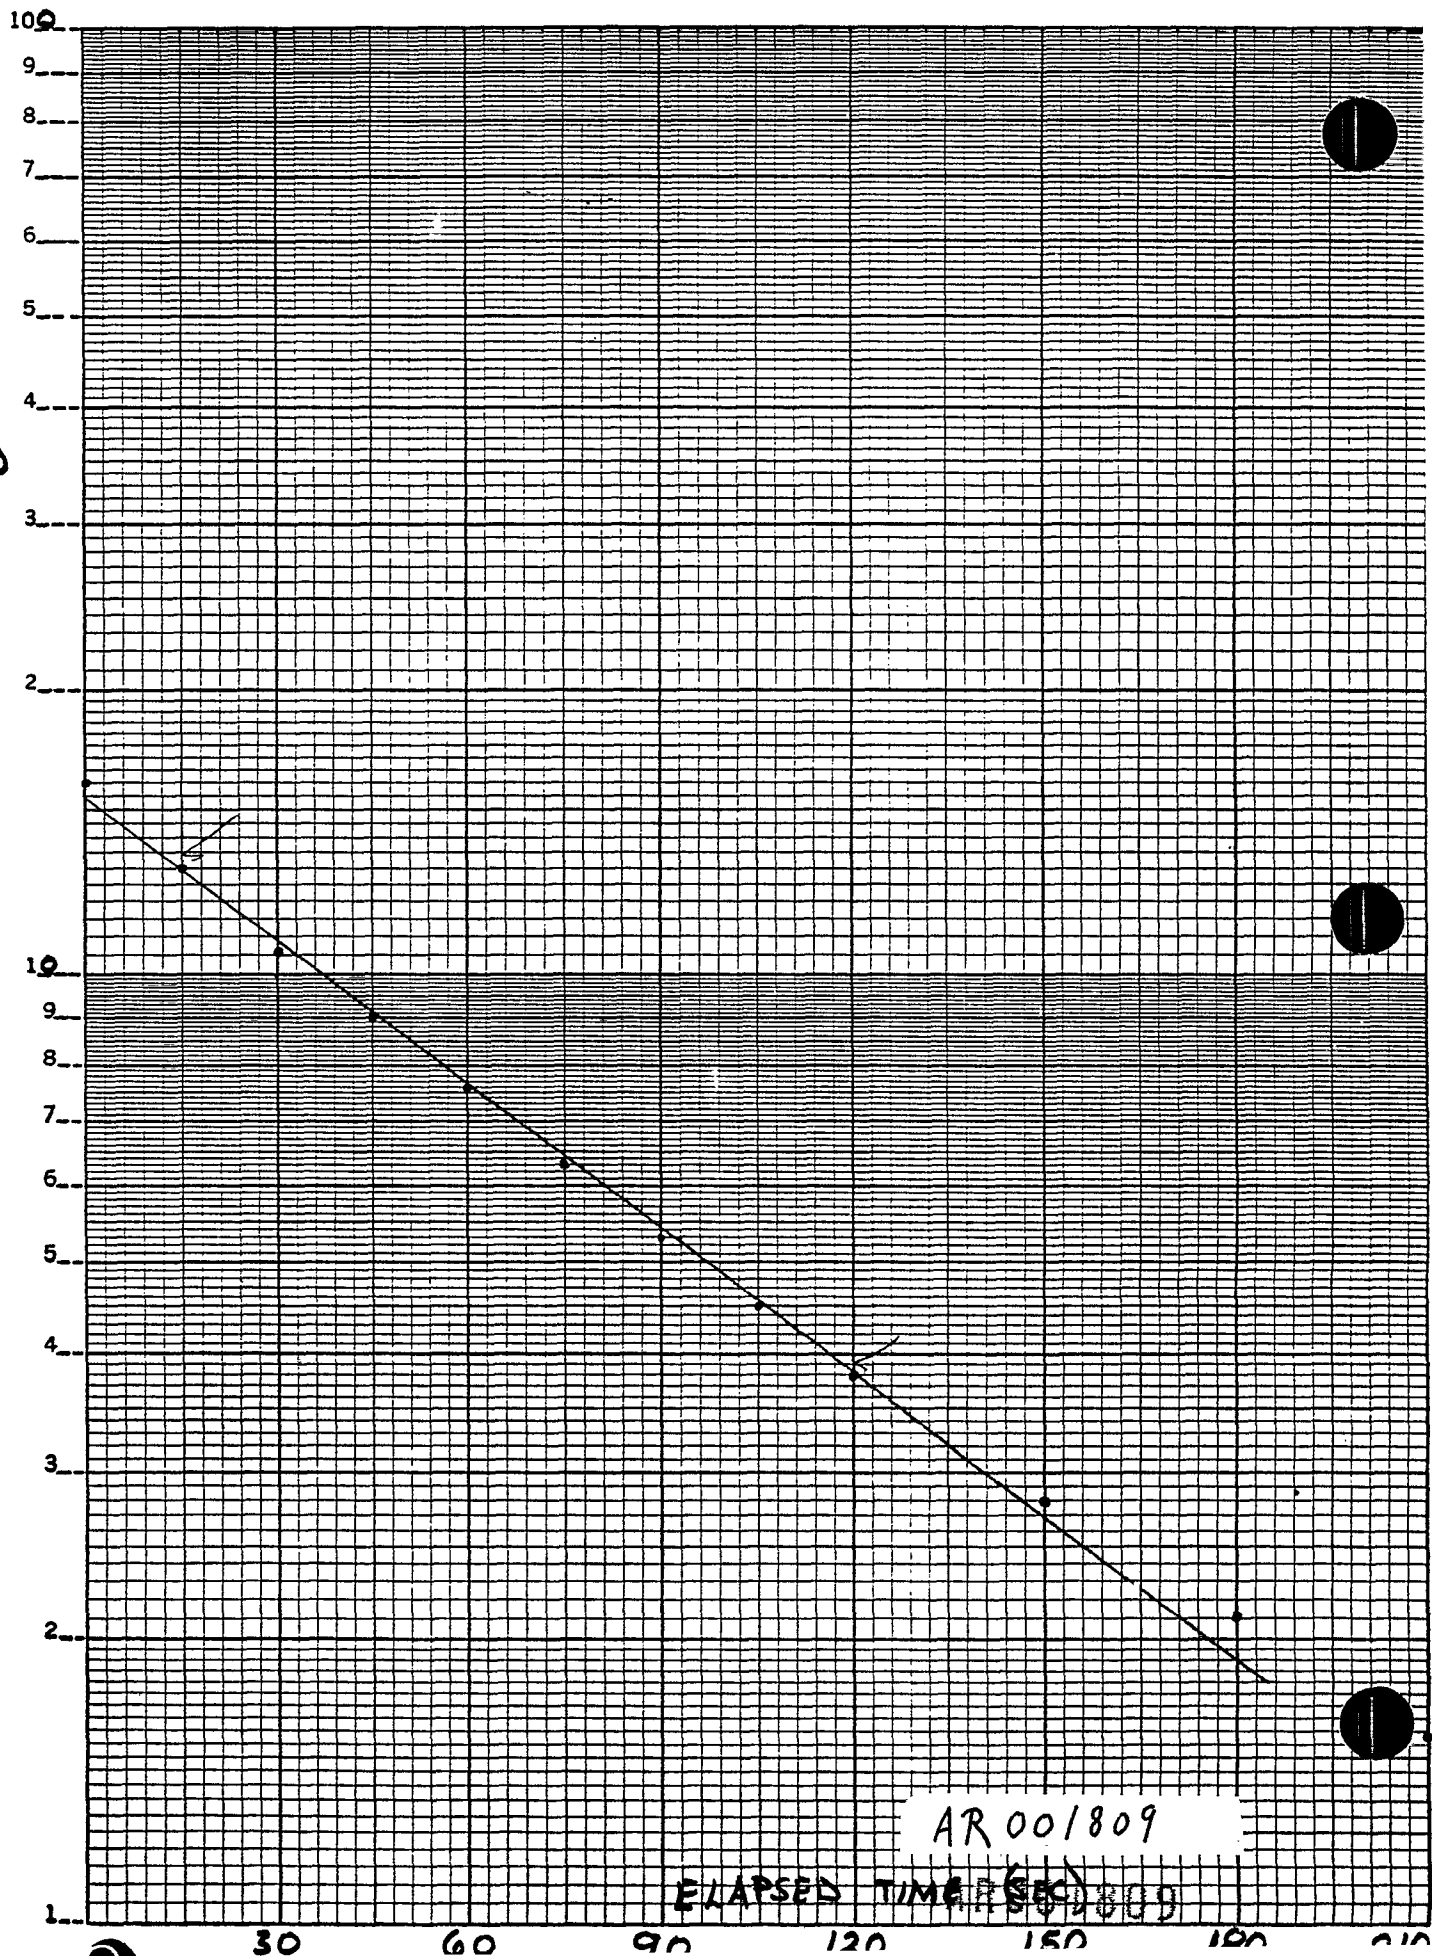

$$D = \text{ELEV(WATER LEVEL)} - \text{ELEV(BASE OF AQUIFER)}$$

$$= H$$

$$=$$

$$H = \text{ELEV(WATER LEVEL)} - \text{ELEV(BASE OF WELL)}$$

$$= 37.00 + 2.20 - 14.02 = 15.18'$$


$$=$$

$$r_w = \text{BOREHOLE } \phi = 0.5'$$

$$L = \text{SCREEN LENGTH (OR SATURATED}$$

$$\text{SCREENED INTERVAL IF SMALLER)}$$

$$= 7.5'$$

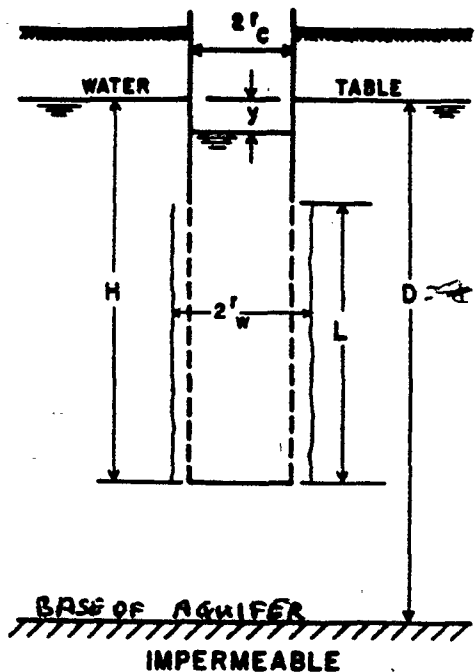

$$r_c = \text{WELL } \phi = 0.167'$$

$$y_0 = \text{INITIAL DRAWDOWN} = 1.98$$

$$y_t = \text{DRAWDOWN AT TIME (t)} = 0.82$$

$$t = \text{TIME t sec} = 10$$

$$L/r_w = 15.0$$

$$A =$$

$$B =$$

$$C = 1.5$$

$$\ln \frac{R_e}{r_w} = \left[\frac{1.1}{\ln H/r_w} + \frac{A + B \ln[(D-H)/r_w]}{L/r_w} \right]^{-1} =$$

$$=$$

$$\ln \frac{R_e}{r_w} = \left(\frac{1.1}{\ln H/r_w} + \frac{C}{L/r_w} \right)^{-1} = \left(\frac{1.1}{3.413} + \frac{1.5}{15.0} \right)^{-1} = 2.368$$

$$K = \frac{r_c^2 \ln(R_e/r_w)}{2L} \left(\frac{1}{t} \right) \ln \frac{y_0}{y_t} = \frac{(0.167)^2 (2.368)}{2(7.50)} \cdot \frac{1}{10} \cdot \ln \frac{1.98}{.82}$$

$$= .0003881 \text{ ft/sec} \times \frac{12 \text{ in}}{\text{ft}} \times \frac{2.54 \text{ cm}}{\text{in}} = 1.2 \times 10^{-2} \text{ cm/sec}$$

$$.0038814$$


AR001810

DRAWING PAPER NO. 1371-21
TRACING PAPER NO. 1230-21
SEMI-LOG. 3 CY. 8Y 10 DIV. / IN.

AQUADEE

MADE IN USA

Log

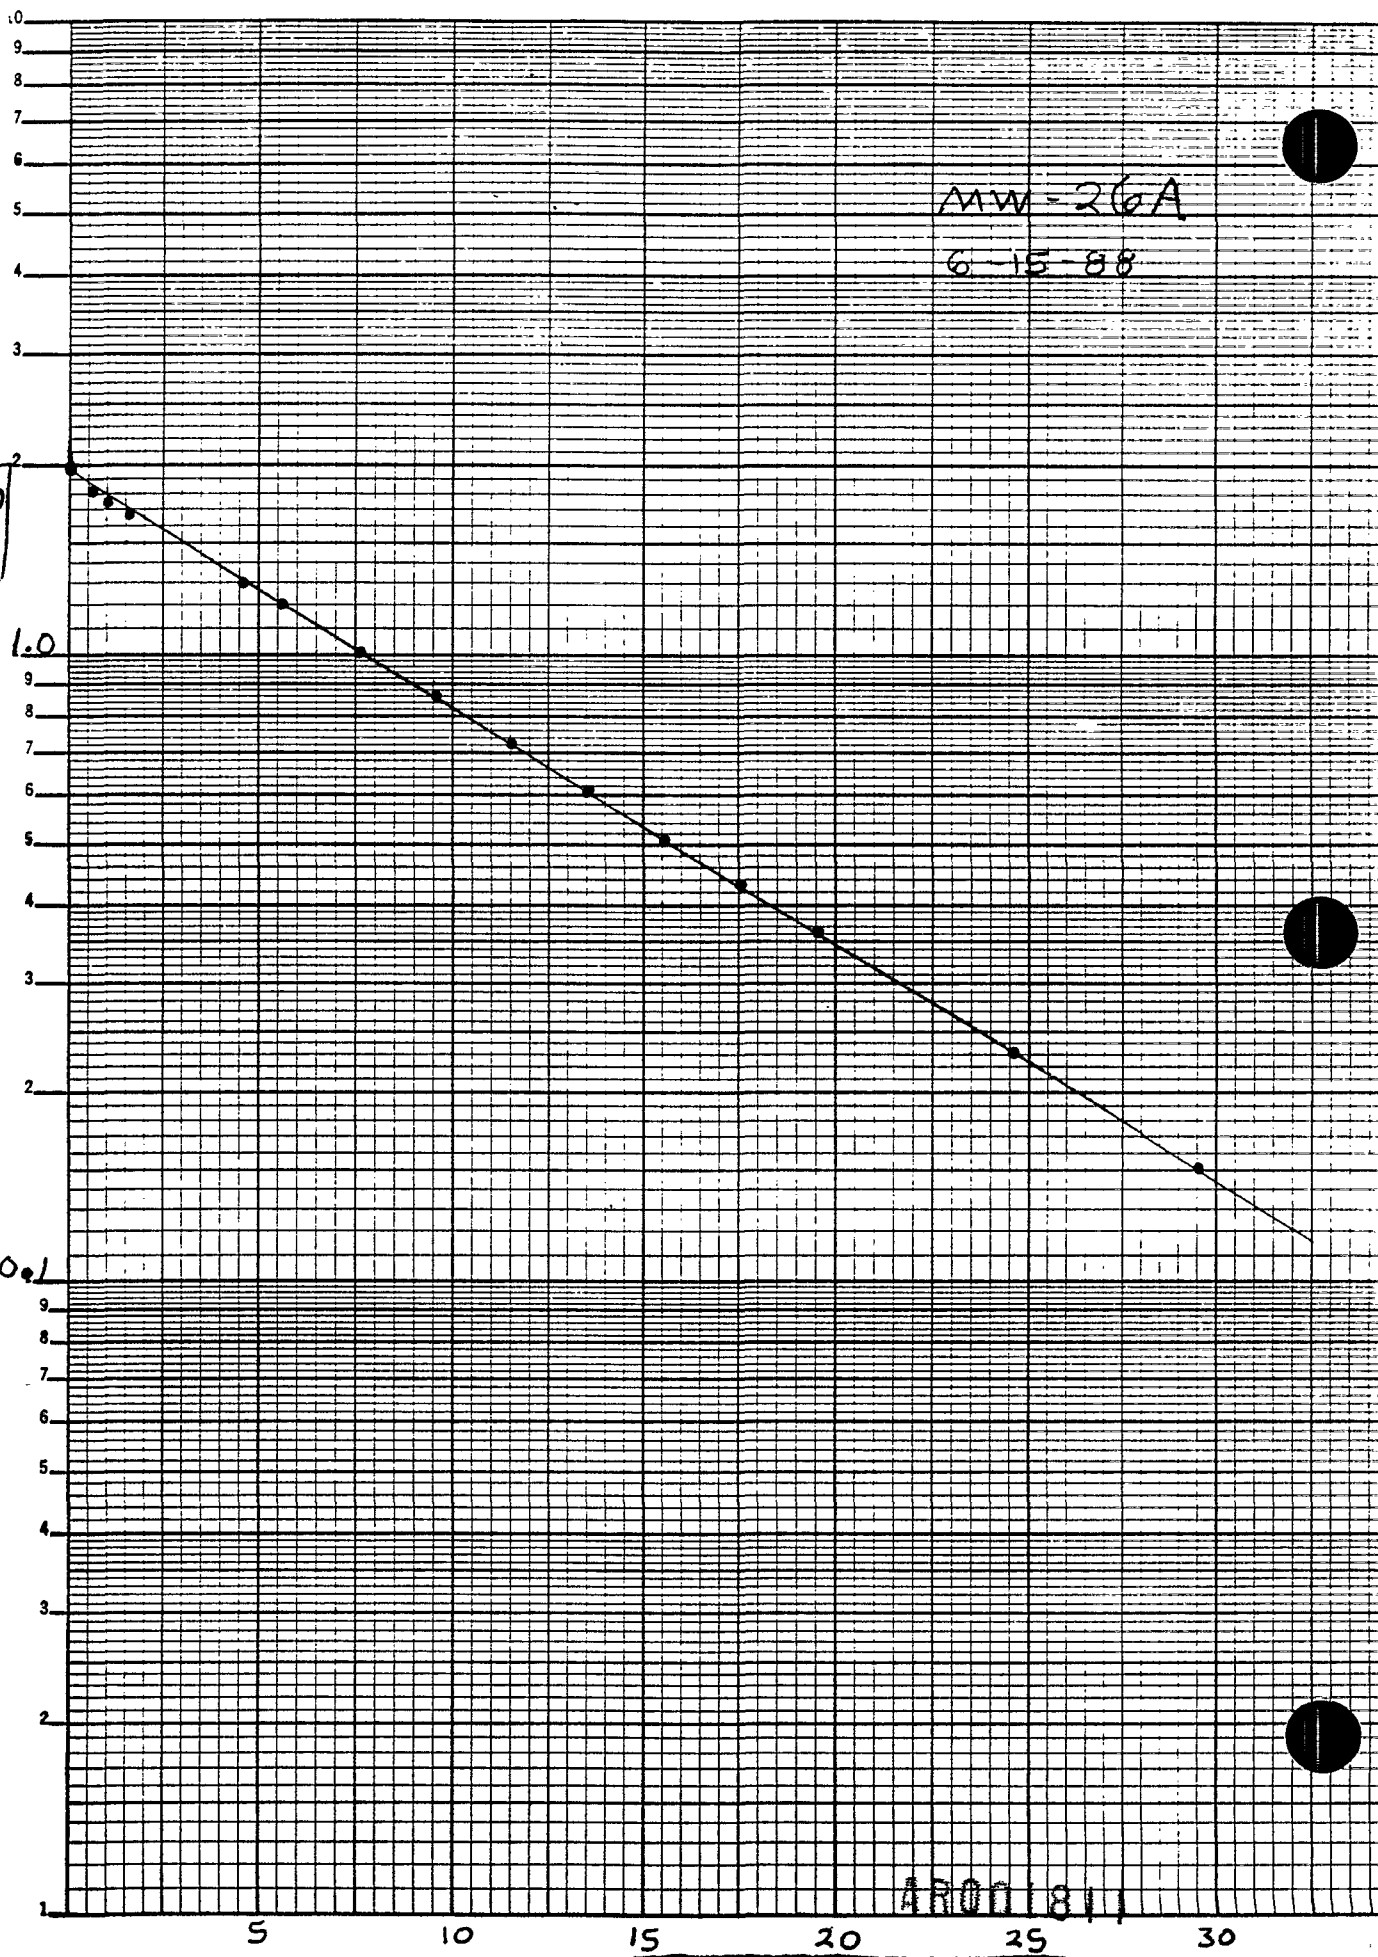

FIELD DATA SHEET IN-SITU HYDRAULIC CONDUCTIVITY TEST

PROJECT NUMBER AND CLIENT NAME 0285-23-1 ARMY COE		LOCATION MILLCREEK	DATE OF TEST 6/15/88	WELL NUMBER 26A	
TEST TYPE RISING HEAD	TEST METHOD (EQUIP.) REMOVE 2" DIAM SOLID SLUG - MONITOR WATER LEVEL W/ TRANSDUCER		INITIAL WATER LEVEL BELOW REF. l_i (ft.) 14.02 TOC	TESTED BY: RNO	
CLOCK TIME	ELAPSED TIME (t) Units: SEC.	WATER LEVEL BELOW REF. AT TIME $t(l_t)$ (Ft)	HEAD AT TIME $t(h_t)$ $h_t = l_t - l_i$	HEAD RATIO h_t/h_0	REMARKS
	0	16.00	1.98	1.0	✓
	0.2	15.91	1.89		
	0.4	15.89	1.87		
	0.6	15.85	1.83	.92	
	0.8	15.81	1.79		
	1.0	15.78	1.76	.89	✓
	1.2	15.75	1.73	.87	
	1.4	15.72	1.70		
	1.6	15.70	1.68	.85	
	2.6	15.56	1.54	.78	
	3.6	15.44	1.42		
	4.6	15.32	1.30	.66	✓
	5.6	15.22	1.20	.61	
	6.6	15.13	1.11		
	7.6	15.04	1.02	.52	
	8.6	14.96	.94		
	9.6	14.88	.86	.43	✓
	10.6	14.81	.79		
	11.6	14.75	.73	.37	
	12.6	14.69	.67		
	13.6	14.63	.61	.31	
	14.6	14.58	.56		
	15.6	14.53	.51	.26	
	16.6	14.49	.47		

AR001812

FIELD DATA SHEET
IN-SITU HYDRAULIC CONDUCTIVITY TEST

PROJECT NUMBER AND CLIENT NAME		LOCATION	DATE OF TEST 6/15/88	WELL NUMBER 26A	
TEST TYPE RISING HEAD	TEST METHOD (EQUIP.)		INITIAL WATER LEVEL BELOW REF. l_i (ft.) 14.02 TOL	TESTED BY: RHO	
CLOCK TIME	ELAPSED TIME (t) Units: <u>sec</u>	WATER LEVEL BELOW REF. AT TIME $t(l_t)$ (Ft)	HEAD AT TIME $t(h_t)$ $h_t = l_t - l_i$	HEAD RATIO h_t/h_o	REMARKS
	17.6	14.45	.43	.22	
	18.6	14.42	.40		
	19.6	14.38	.36	.18	✓
	24.6	14.25	.23	.12	
	29.6	14.17	.15	.08	
	34.6	14.11	.09		
	39.6	14.08	.06		
	44.6	14.06	.04		
	49.6	14.05	.03		
	54.6	14.04	.02		
	59.6	14.03	.01		

AR001813

ORIGINAL
(RED)

$$D = \text{ELEV(WATER LEVEL)} - \text{ELEV(BASE OF AQUIFER)}$$

$$= 27.0 + 2.02 - 12.65 = 16.37$$

$$H = \text{ELEV(WATER LEVEL)} - \text{ELEV(BASE OF WELL)}$$

$$= 25.25 + 2.02 - 12.65 = 4.62$$

$$r_w = \text{BOREHOLE } \phi = .5'$$

$$L = \text{SCREEN LENGTH (OR SATURATED SCREENED INTERVAL IF SMALLER)}$$

$$= 16.0 - 9.1 - 1.20^* = 5.7'$$


* Un saturated length of Sand Pack

$$r_c = \text{WELL } \phi = .167'$$

$$y_0 = \text{INITIAL DRAWDOWN} = 2.12'$$

$$y_t = \text{DRAWDOWN AT TIME (t)} = 0.71'$$

$$t = \text{TIME t MIN} = 16$$

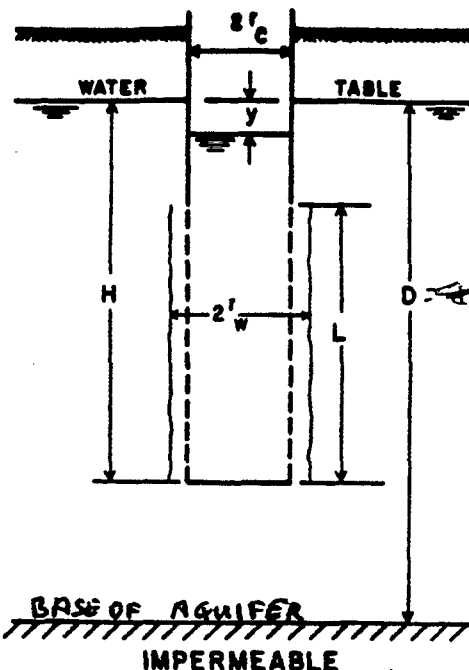

$$L/r_w = 11.40$$

$$A = 1.95$$

$$B = 1.25$$

$$C =$$

$$\ln \frac{R_e}{r_w} = \left[\frac{1.1}{\ln H/r_w} + \frac{A + B \ln[(D-H)/r_w]}{L/r_w} \right]^{-1}$$


$$= \left(\frac{1.1}{2.2235} + \frac{1.95 + 1.25 (3.1570)}{11.40} \right)^{-1} = .9882$$

$$\ln \frac{R_e}{r_w} = \left(\frac{1.1}{\ln H/r_w} + \frac{C}{L/r_w} \right)^{-1}$$

$$K = \frac{r_c^2 \ln(R_e/r_w)}{2L} \left(\frac{1}{t} \right) \ln \frac{y_0}{y_t} = \frac{(.167)^2 (.9882)}{2 (5.70)} \cdot \frac{1}{16} \cdot \ln \frac{2.12}{.71}$$

$$= 1.6529 \times 10^{-4} \frac{\text{ft}}{\text{MIN}} \times \frac{1 \text{ MIN}}{60 \text{ sec}} \times \frac{12 \text{ in}}{\text{ft}} \times \frac{2.54 \text{ cm}}{\text{in}} = 8.4 \times 10^{-5} \frac{\text{cm}}{\text{sec}}$$

AR001814

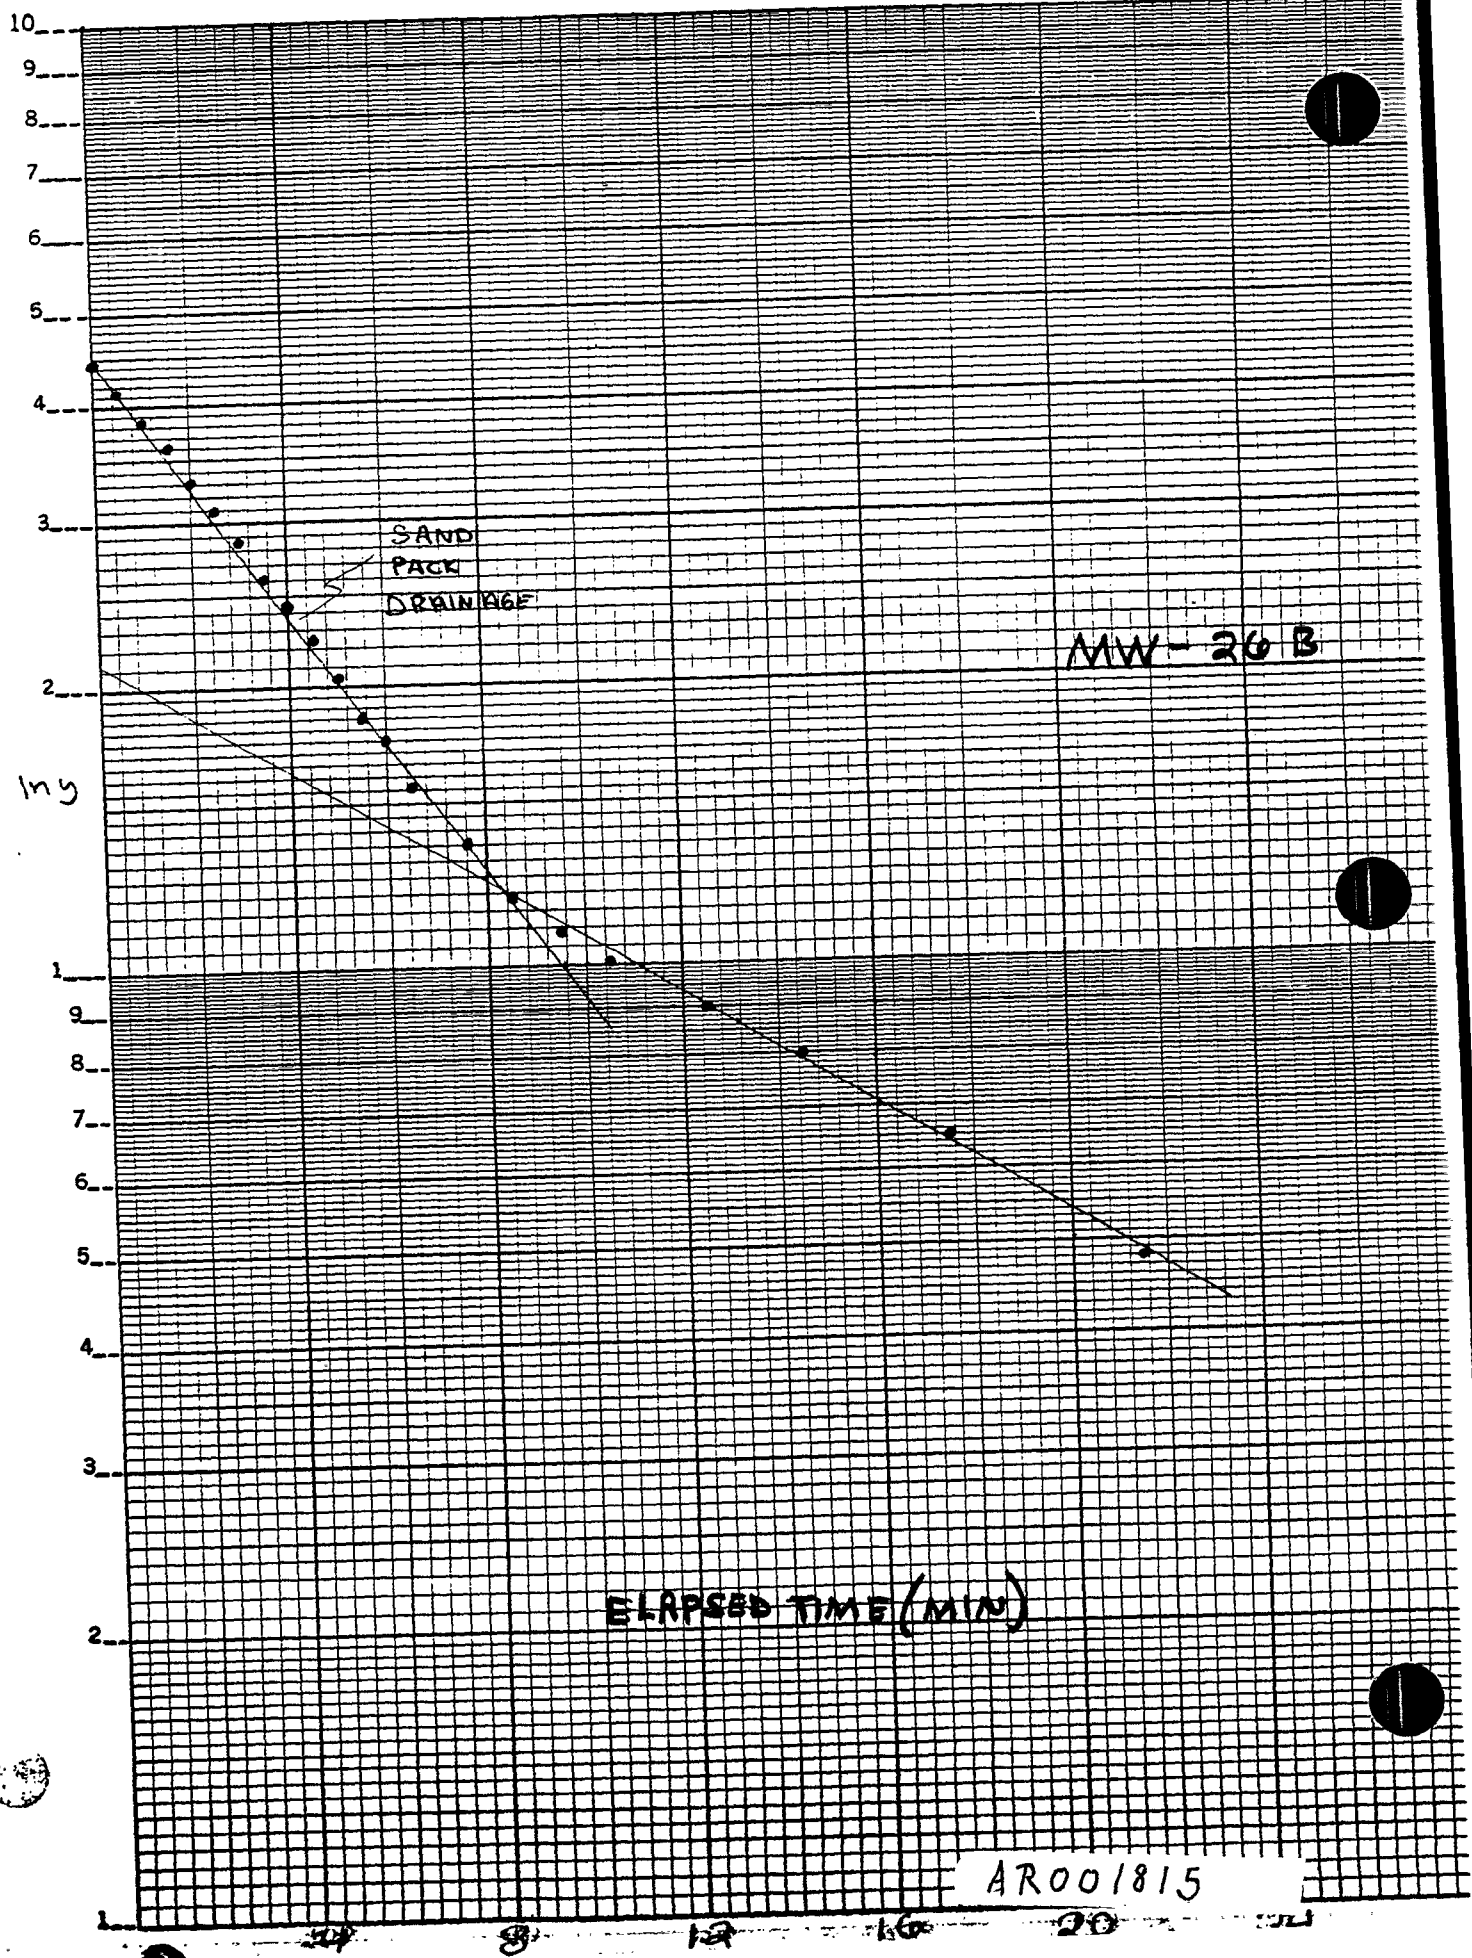

FIELD DATA SHEET

IN SITU HYDRAULIC CONDUCTIVITY TEST

ORIGINAL
(RED)

PROJECT NUMBER AND CLIENT NAME Millcreek	LOCATION Eire	DATE OF TEST 5/31/88	WELL NUM 2013
TEST TYPE Rising Head	TEST METHOD (EQUIP) Bail Hgal	INITIAL WATER LEVEL BELOW REF. 2.1 (ft) 12.65' Below Steel	TESTED BY JRH

CLOCK TIME	ELAPSED TIME	WATER LEVEL BELOW REF. AT TIME t (2t) (ft)	HEAD AT TIME t (ht) ht = 2t - 2i	Head Ratio ht/h0	REMARKS
1:02:30	0	17.10	4.45		
03:00	.50	16.80	4.15		
3:30	1.00	16.50	3.35		
4:00	1.50	16.25	3.20		
4:30	2.00	15.98	3.33		
5:00	2.50	15.77	3.03		
5:30	3.00	15.50	2.35		
6:00	3.50	15.25	2.60		
6:30	4.0	15.07	2.42		
7:00	4.50	14.87	2.22		
7:30	5.00	14.68	2.03		
8:00	5.50	14.51	1.86		
8:30	6.00	14.36	1.71		
9:00	6.50	14.22	1.57		
10:00	7.50	14.00	1.35		
11:00	8.50	13.84	1.19		
12:00	9.50	13.74	1.09		
13:00	10.50	13.66	1.01		
15:00	12.50	13.55	0.90		
17:00	14.50	13.45	0.80		
20:00	17.50	13.30	0.65		
24:00	21.50	13.13	0.48		
32:00	29.50	12.88	0.23		

AR001816

FIELD DATA SHEET

IN-SITU HYDRAULIC CONDUCTIVITY TEST

PROJECT NUMBER AND CLIENT NAME 7295-23-1 COE		LOCATION MILLCREEK	DATE OF TEST 2-17-98	WELL NUMBER 26B	
TEST TYPE Falling Head	TEST METHOD (EQUIP.) Add 3gal of Water		INITIAL WATER LEVEL BELOW REF. l_i (ft.) 13.12	TESTED BY:	
CLOCK TIME	ELAPSED TIME (t) Units: _____	WATER LEVEL BELOW REF. AT TIME $t(l_t)$ (Ft)	HEAD AT TIME $t(h_t)$ $h_t = l_t - l_i$	HEAD RATIO h_t/h_0	REMARKS
402:20 ↓ 402:30	Add 3gals	Flow thru screen into rapid and audible			was
402:50		12.10			
403:10		12.15			
403:20		12.20			
403:50		12.25			
104:30		12.30			
05:30		12.35			
07:05		12.40			
08:00		12.42			
10:00		12.48			
12:00		12.51			
15:30		12.57			
17:00		12.62			
18:45		12.70			
20:45		12.80			
22:05		12.85			
24:05		12.90			
26:45		12.95			
30:00		13.00			

AR001817

$$D = \text{ELEV(WATER LEVEL)} - \text{ELEV(BASE OF AQUIFER)}$$

$$= H$$


$$H = \text{ELEV(WATER LEVEL)} - \text{ELEV(BASE OF WELL)}$$

$$= 30.0 + 2.3 - 10.46 = 21.84'$$

$$r_w = \text{BOREHOLE } \phi = 0.5'$$

$$L = \text{SCREEN LENGTH (OR SATURATED SCREENED INTERVAL IF SMALLER)}$$

$$= 31.0 - 22.8 = 8.2'$$

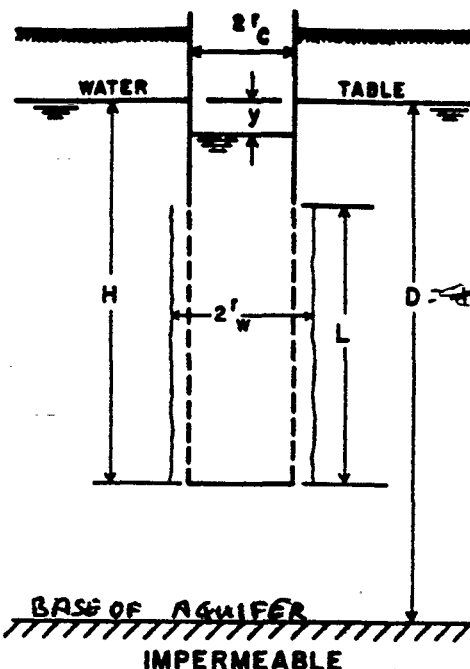

$$r_c = \text{WELL } \phi = .167'$$

$$y_0 = \text{INITIAL DRAWDOWN} = 3.46'$$

$$y_t = \text{DRAWDOWN AT TIME (t)} = .53'$$

$$t = \text{TIME t min} = 14$$

$$L/r_w = 16.4$$

$$A =$$

$$B =$$

$$C = 1.75$$

$$\ln \frac{R_e}{r_w} = \left[\frac{1.1}{\ln H/r_w} + \frac{A + B \ln[(D-H)/r_w]}{L/r_w} \right]^{-1}$$

$$\ln \frac{R_e}{r_w} = \left(\frac{1.1}{\ln H/r_w} + \frac{C}{L/r_w} \right)^{-1} = \left(\frac{1.1}{3.78} + \frac{1.75}{16.4} \right)^{-1} = 2.514$$


$$K = \frac{r_c^2 \ln(R_e/r_w)}{2L} \left(\frac{1}{t} \right) \ln \frac{y_0}{y_t} = \frac{(.167)^2 (2.514)}{2(8.2')} \cdot \frac{1}{14} \cdot \ln \frac{3.46}{.53}$$

$$= 5.729 \times 10^{-4} \frac{\text{ft}}{\text{min}} \times \frac{12 \text{ in}}{\text{ft}} \times \frac{2.54 \text{ cm}}{\text{in}} \times \frac{1 \text{ min}}{60 \text{ s}} = 2.9 \times 10^{-4} \text{ cm/sec}$$

DRAWING PAPER NO. 1371-21
TRACING PAPER NO. 1230-21
SEMI-LOG. 3 CY. BY 10 DIV./ IN.

AQUABEL
MADE IN USA

Phy

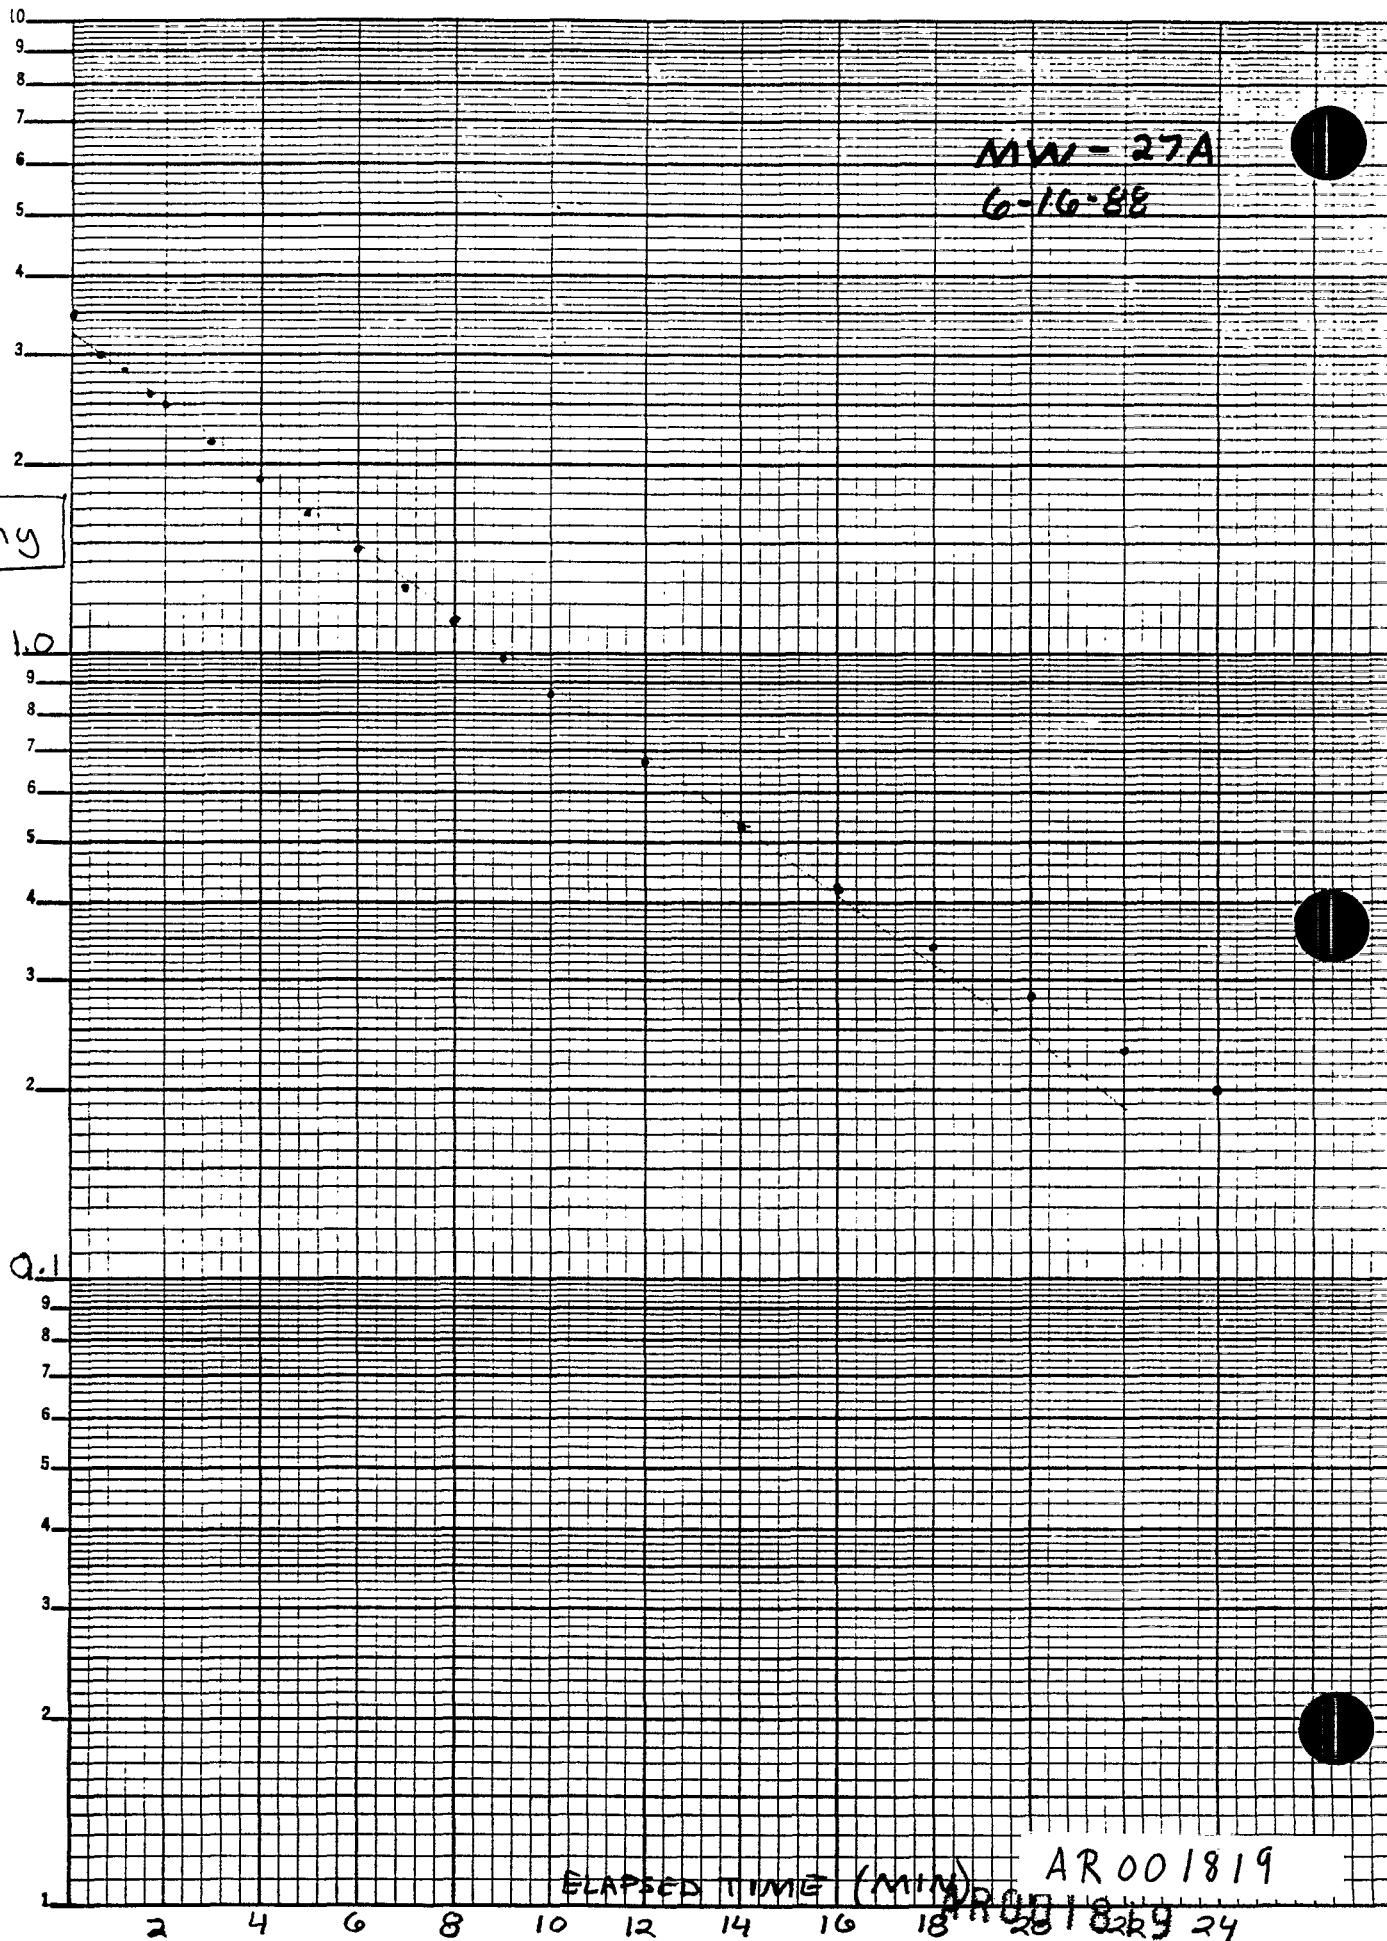

$$D = \text{ELEV(WATER LEVEL)} - \text{ELEV(BASE OF AQUIFER)}$$

$$= 15.5 + 2.05 - 10.55 = 7.00'$$

$$H = \text{ELEV(WATER LEVEL)} - \text{ELEV(BASE OF WELL)}$$

$$= 12.65 + 2.05 - 10.55 = 4.15'$$

$$r_w = \text{BOREHOLE } \phi = 0.5'$$

$$L = \text{SCREEN LENGTH (OR SATURATED SCREENED INTERVAL IF SMALLER)}$$

$$= 12.3 - 6.0 - 2.1^* = 4.2'$$

* Non Sat. Section of Sand Pack

$$r_c = \text{WELL } \phi = .167'$$

$$y_0 = \text{INITIAL DRAWDOWN} = 1.35'$$

$$y_t = \text{DRAWDOWN AT TIME } (t) = .35'$$

$$t = \text{TIME } t \text{ SEC} = 27$$


$$L/r_w = 8.4$$

$$A = 1.95$$

$$B = 1.25$$

$$C =$$

* NOTE: 15 1/2 BAGS OF SAND PACK ADDED TO STABILIZE GRAVEL LENS. USED EARLY TIME DATA AS MORE REPRESENTATIVE OF PERMEABLE GRAV

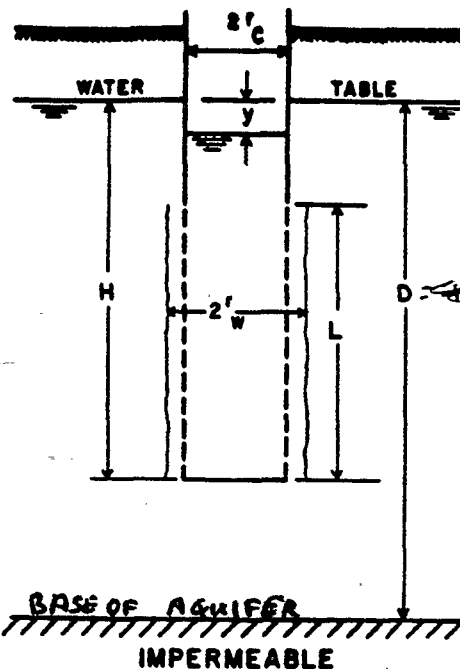

$$\ln \frac{R_e}{r_w} = \left[\frac{1.1}{\ln H/r_w} + \frac{A + B \ln[(D-H)/r_w]}{L/r_w} \right]^{-1}$$

$$= \left(\frac{1.1}{2.1163} + \frac{1.95 + 1.25 (1.7405)}{8.4} \right)^{-1} = .9892$$

$$\ln \frac{R_e}{r_w} = \left(\frac{1.1}{\ln H/r_w} + \frac{C}{L/r_w} \right)^{-1}$$

$$K = \frac{r_c^2 \ln(R_e/r_w)}{2L} \left(\frac{1}{t} \right) \ln \frac{y_0}{y_t} = \frac{(.167)^2 (.9892)}{2(4.2)} \frac{1}{27} \ln \frac{1.35}{.35}$$

$$= 1.642 \times 10^{-4} \frac{\text{ft}}{\text{sec}} \times \frac{12 \text{ in}}{\text{ft}} \times \frac{2.54 \text{ cm}}{\text{in}} = 5.0 \times 10^{-3} \frac{\text{cm}}{\text{sec}}$$


AR001821

DRAWING PAPER NO. 1371-21
TRACING PAPER NO. 1230-21
SEMI-LOG. 3 CY. BY 10 DIV./ IN.

lny

AUABLE

MADE IN USA

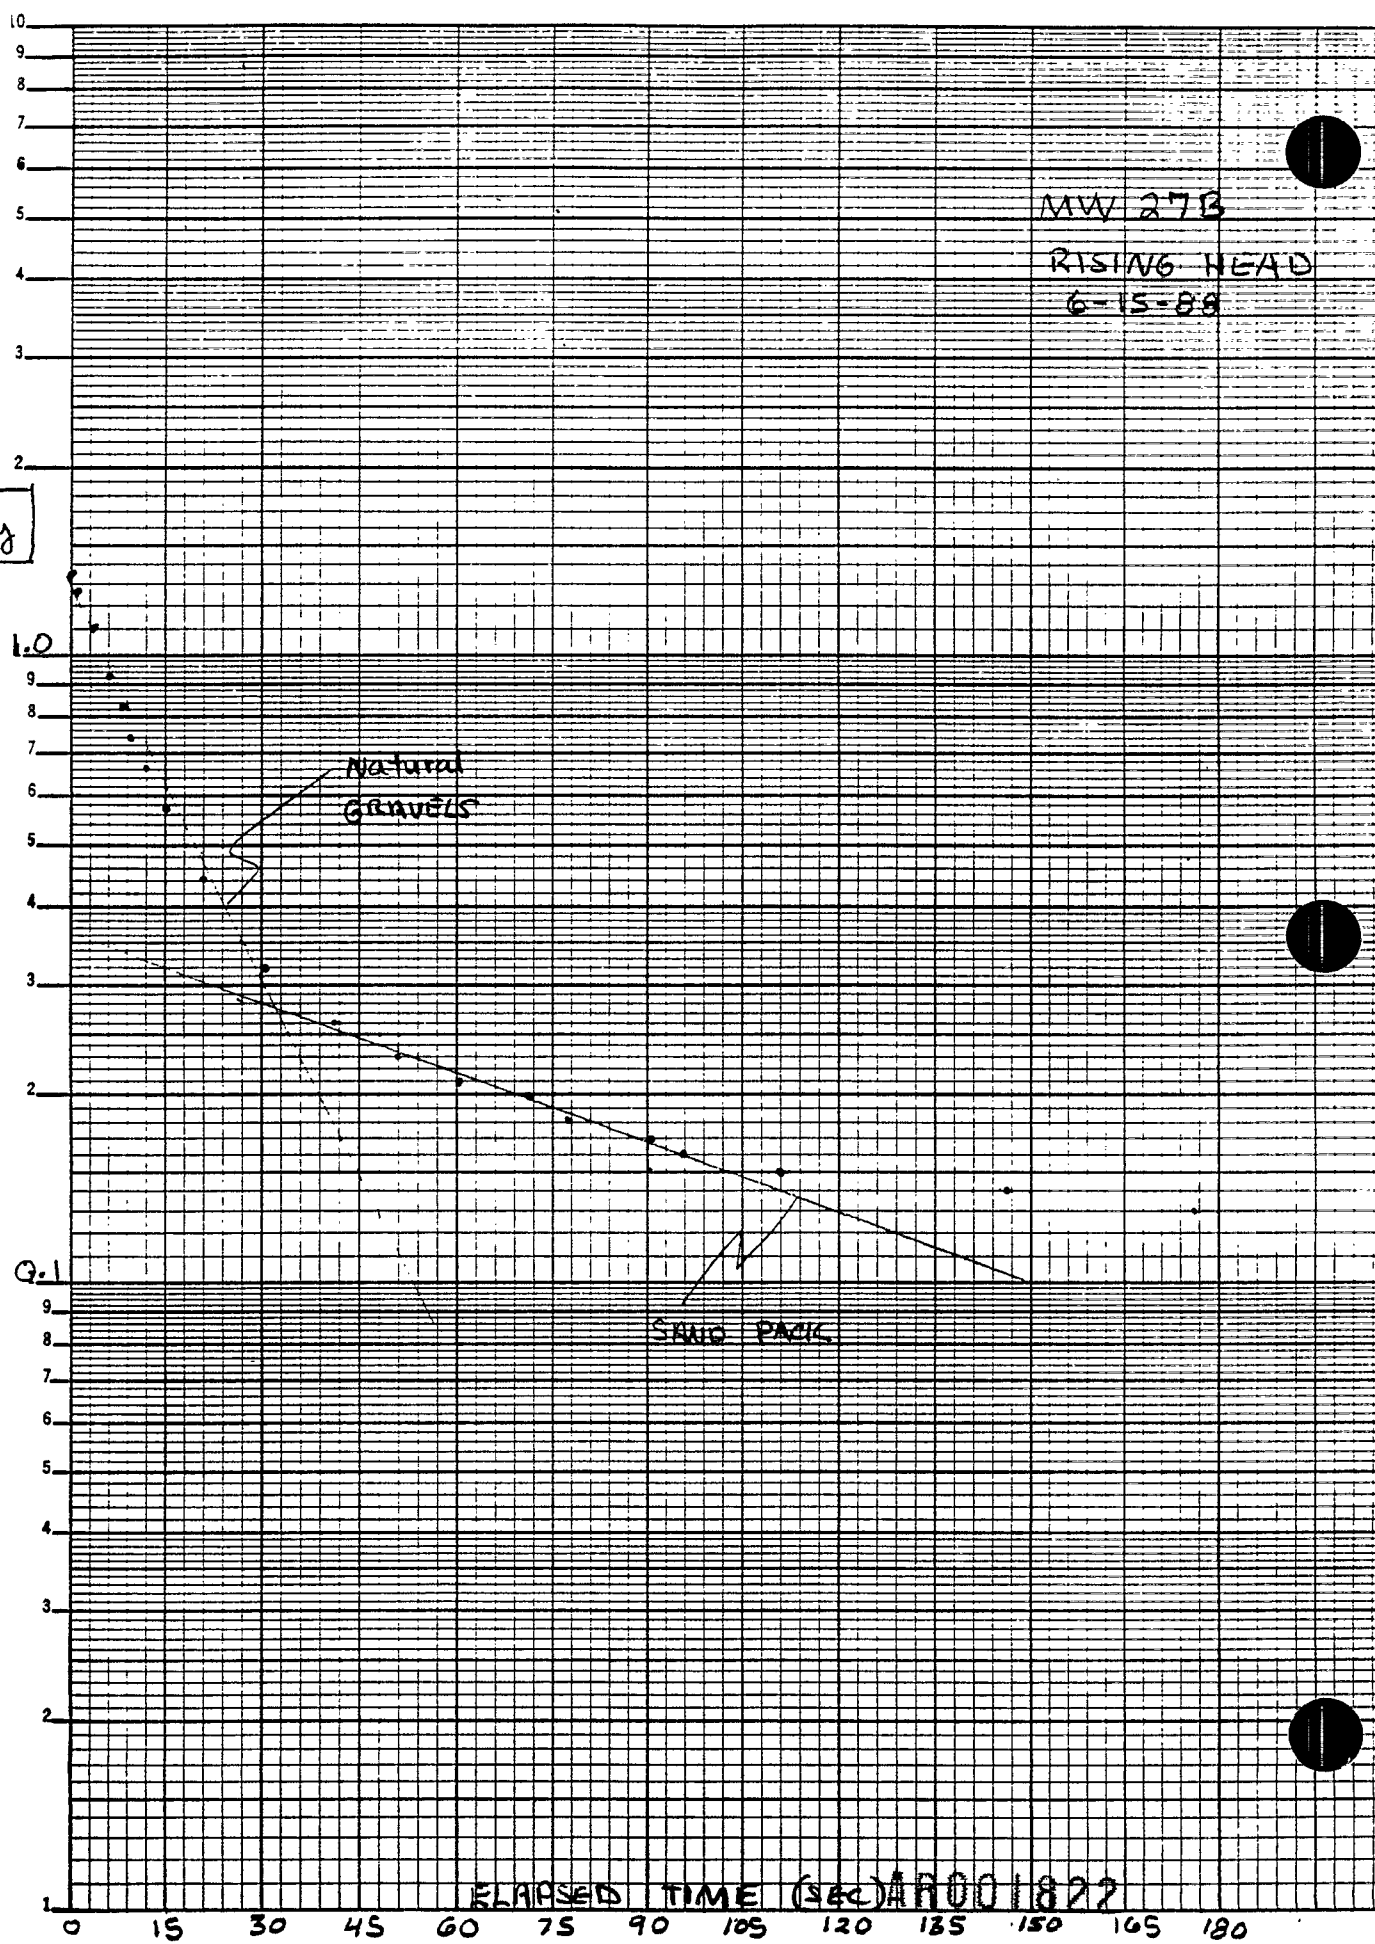

AR001822

ORIGINAL
(RED)

FIELD DATA SHEET

IN-SITU HYDRAULIC CONDUCTIVITY TEST

PROJECT NUMBER AND CLIENT NAME 0285-23-1 COE		LOCATION MILLCREEK	DATE OF TEST 6-15-88	WELL NUMBER 27B	
TEST TYPE RISING HEAD	TEST METHOD (EQUIP.) 2" PVC SLUG & TRANSDUCER		INITIAL WATER LEVEL BELOW REF. l_i (ft.) 10.55 STEEL		TESTED BY: RHO
CLOCK TIME	ELAPSED TIME (t) Units: <u>sec</u>	WATER LEVEL BELOW REF. AT TIME $t(l_t)$ (Ft)	HEAD AT TIME $t(h_t)$ $h_t = l_t - l_i$	HEAD RATIO h_t/h_o	REMARKS
	0	11.90	1.35		
	1	11.81	1.26		
	2	11.72	1.17		
	3	11.65			
	4	11.58	1.10		
	5	11.52			
	6	11.47	0.92		
	7	11.42			
	8	11.38	0.83		
	9	11.33			
	10	11.29	0.74		
	11	11.25			
	12	11.21	0.66		
	13	11.18			
	14	11.15			
	15	11.12	0.57		
	16	11.09			
	21	10.99	0.44		
	26	10.92			
	31	10.87	0.32		
	36	10.83			
	41	10.81	0.26		
	46	10.79			
	51	10.78	0.23		
	56	10.77			
	61	10.76	0.21		
	66	10.75			
	71	10.75	0.20		
	76	10.73	0.18		
	81	10.72	0.17		
	86	10.71	0.16		
	91	10.70	0.15		
	146	10.69	0.14		
	176	10.68	0.13		
					AR001823

** VARIABLE HEAD PERMEABILITY TEST **

ORIGINAL
(RED)

PROJECT NAME: MILLCREEK

PROJECT NUMBER: 0285-23-1

DATE TESTED: 5-20-88

WELL NUMBER: MW-28A

INITIAL WATER LEVEL (L_i): 5.42 FT TOC

ELAPSED TIME (MIN)	WATER LEVEL AT TIME t (L _t) (FT)	HEAD AT TIME t (H _t) H _t = L _t (FT)	HEAD RATIO H _t /H _o
0.0	16.00	10.6	1.00
0.3	15.69	10.3	0.97
0.8	15.17	9.8	0.92
1.3	14.69	9.3	0.88
1.8	14.27	8.9	0.84
2.3	13.86	8.4	0.80
2.8	13.47	8.1	0.76
3.3	13.09	7.7	0.72
3.8	12.72	7.3	0.69
4.3	12.40	7.0	0.66
4.8	12.05	6.6	0.63
5.3	11.75	6.3	0.60
5.8	11.43	6.0	0.57
6.3	11.15	5.7	0.54
6.8	10.87	5.4	0.52
7.3	10.60	5.2	0.49
7.8	10.31	4.9	0.46
8.3	10.07	4.6	0.44
9.3	9.60	4.2	0.40
10.3	9.20	3.8	0.36
11.3	8.80	3.4	0.32
12.3	8.47	3.1	0.29
13.3	8.17	2.8	0.26
14.3	7.85	2.4	0.23
16.3	7.33	1.9	0.18
18.3	6.62	1.2	0.11
20.3	6.58	1.2	0.11
23.5	6.18	0.8	0.07
27.3	5.84	0.4	0.04
30.3	5.68	0.3	0.02

WELL RADIUS (r) = 2 INCHES

SAND PACK RADIUS (R) = 6 INCHES

LENGTH OF SAND PACK (L) = 12.3 FT

FIRST HEAD RATIO (H₁) 0.66

ELAPSED TIME IN MINUTES (T₁) 4.3

SECOND HEAD RATIO (H₂) 0.23

ELAPSED TIME IN MINUTES (T₂) 14.3

$$K = \frac{r^2 * \ln (L/R) * \ln (H_1/H_2)}{2 (L) * (T_2 - T_1) * 60 \text{ SEC/MIN}}$$

** K = 1.927034E-04 CM/SEC **

AR001824 OK RH=

NOTE: DATA IS CONVERTED FROM ENGLISH TO METRIC UNITS

ORIGINAL
(RED)

* VARIABLE HEAD PERMEABILITY TEST **

PROJECT NAME: GULL TEEK PROJECT NUMBER: 0008-23-1

DATE TESTED: 5-20-88 WELL NUMBER: MW-28B

INITIAL WATER LEVEL (Li): 5.1 FT TOC

ELAPSED TIME (MIN)	WATER LEVEL AT-TIME t (Lt) (FT)	HEAD AT TIME t (Ht) Ht = Lt (FT)	HEAD RATIO Ht/Ho
0.0	11.10	6.0	1.00
0.5	7.92	4.8	0.80
0.8	7.45	4.3	0.72
1.0	7.05	4.0	0.67
1.5	6.40	3.3	0.55
2.0	7.65	2.8	0.47
2.5	7.37	2.3	0.38
3.0	7.00	1.9	0.32
3.5	6.68	1.6	0.27
4.0	6.42	1.3	0.22
4.5	6.18	1.1	0.18
5.0	6.00	0.9	0.15
5.5	5.87	0.8	0.13
6.0	5.74	0.6	0.11
6.5	5.65	0.6	0.09
7.0	5.55	0.5	0.08
7.5	5.47	0.4	0.06
8.0	5.42	0.3	0.05

WELL RADIUS (r) = 2 INCHES

SAND PACK RADIUS (R) = 6 INCHES

LENGTH OF SAND PACK (L) = 3.5 FT

FIRST HEAD RATIO (H1) 0.80 ELAPSED TIME IN MINUTES (T1) 0.5

SECOND HEAD RATIO (H2) 0.15 ELAPSED TIME IN MINUTES (T2) 5.0

$$K = \frac{r^2 * \ln (L/R) * \ln (H1/H2)}{2 (L) * (T2 - T1) * 60 \text{ SEC/MIN}}$$

$$** K = 1.035699E-03 \text{ CM/SEC} **$$


NOTE: DATA IS CONVERTED FROM ENGLISH TO METRIC UNITS

AR001825


OK RHI

ORIGINAL
(RED)

HEAD RATIO

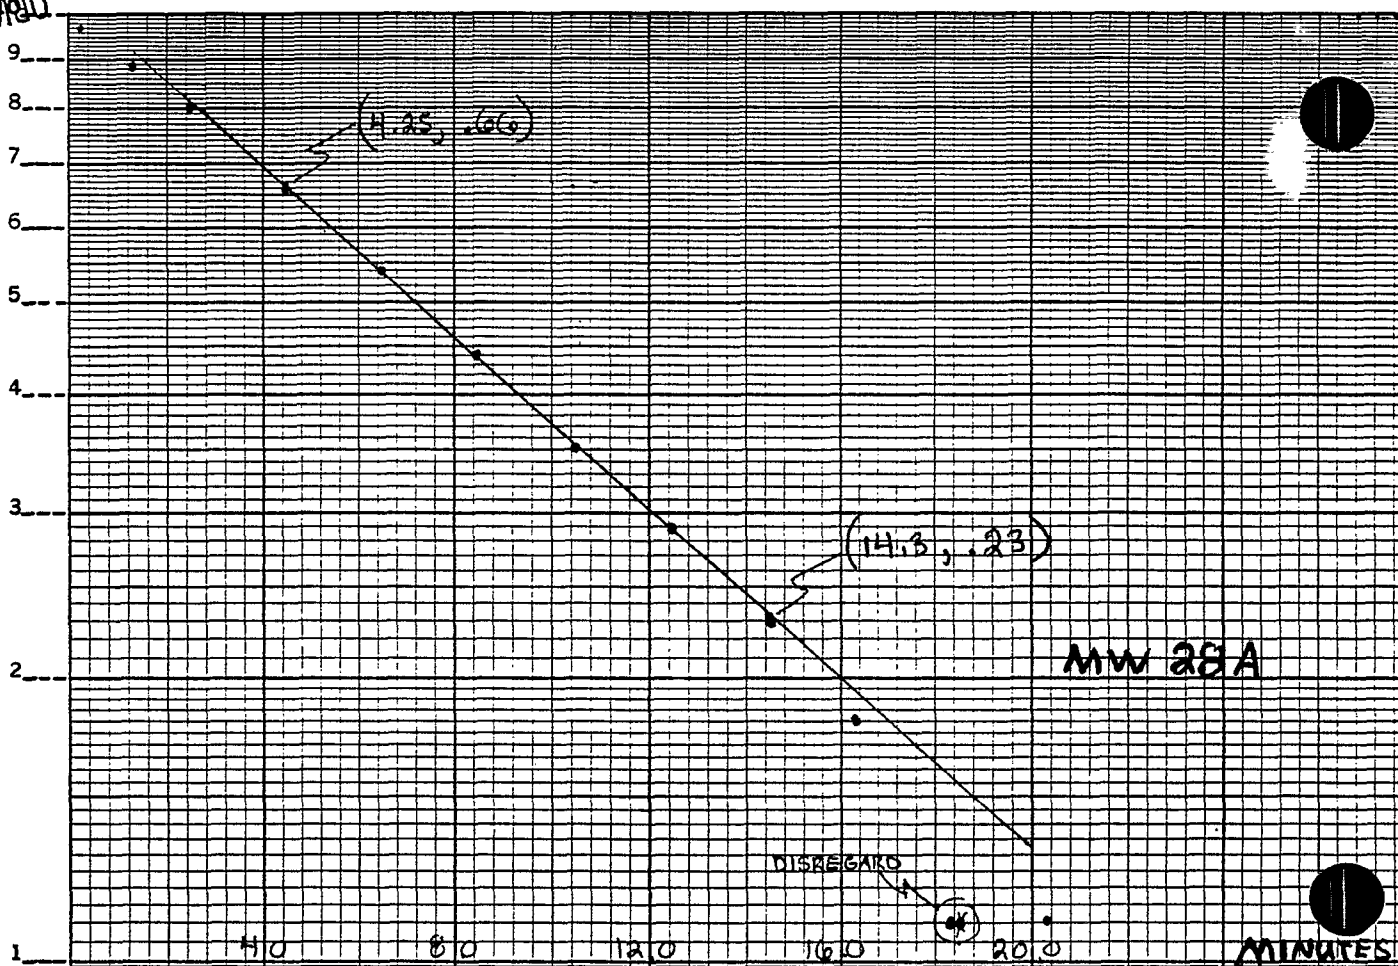

HEAD RATIO

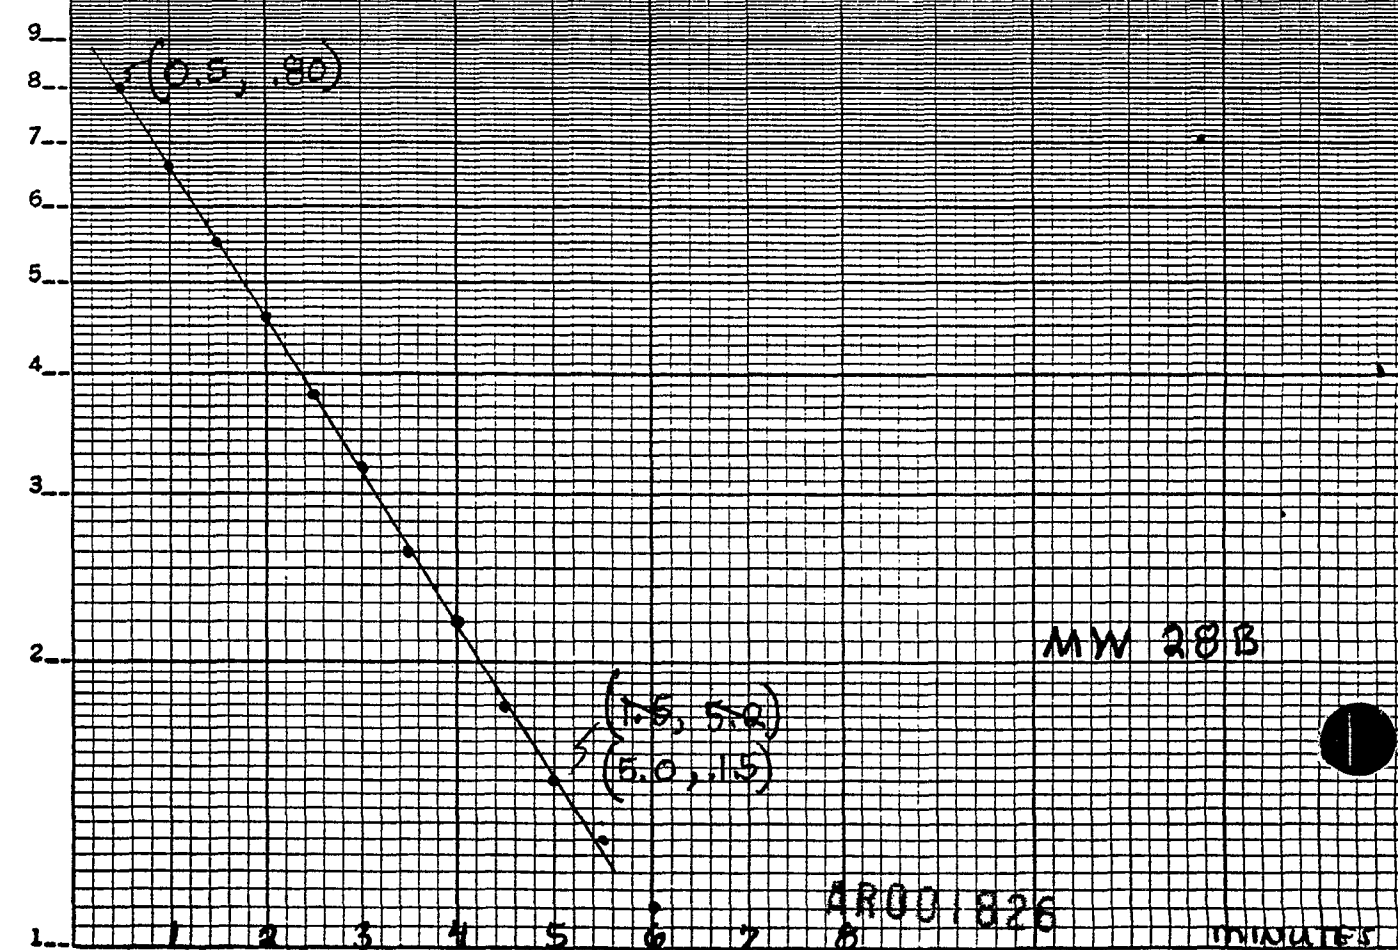

AR001826

MINUTES

FIELD DATA SHEET
IN-SITU HYDRAULIC CONDUCTIVITY TEST

PROJECT NUMBER AND CLIENT NAME <u>ARMY COE 0285-23-1</u>		LOCATION <u>MILLCREEK</u>	DATE OF TEST <u>5/20/88</u>	WELL NUMBER <u>MW-28A</u>	
TEST TYPE <u>RISING HEAD</u>	TEST METHOD (EQUIP.) <u>BAILED</u>	INITIAL WATER LEVEL BELOW REF. l_i (ft.) <u>5.42 TOC</u>		TESTED BY: <u>RHO</u>	

CLOCK TIME	ELAPSED TIME (t) Units: <u>min</u>	WATER LEVEL BELOW REF. AT TIME $t(l_t)$ (Ft)	HEAD AT TIME $t(h_t)$ $h_t = l_t - l_i$	HEAD RATIO h_t/h_0	REMARKS
10:59:45	.25 0	16.00	10.58	1.0	
11:00:00	.25	15.69	10.27	.97	
00:30	.75	15.17	9.75		
1:00	1.25	14.69	9.27	.88	
1:30	1.75	14.27			
2:00	2.25	13.86	8.44	.80	
2:30	2.75	13.47			
3:00	3.25	13.09	7.67		
3:30	3.75	12.72			
4:00	4.25	12.40	6.98	.66	
4:30	4.75	12.05			
5:00	5.25	11.75	6.33		
5:30	5.75	11.43			
6:00	6.25	11.15	5.73	.54	
6:30	6.75	10.87			
7:00	7.25	10.60	5.18		
7:30	7.75	10.31			
8:00	8.25	10.07	4.65	.44	
9:00	9.25	9.60			
10:00	10.25	9.20	3.78	.36	
11:00	11.25	8.80			
12:00	12.25	8.47	3.05	.29	AR001827

FIELD DATA SHEET

IN-SITU HYDRAULIC CONDUCTIVITY TEST

PROJECT NUMBER AND CLIENT NAME <u>0285-23-1 ARMY COE</u>		LOCATION <u>MILLCREEK</u>	DATE OF TEST <u>5/20/88</u>	WELL NUMBER <u>MW-28A</u>	
TEST TYPE <u>RISING HEAD</u>	TEST METHOD (EQUIP.) <u>BAILED</u>		INITIAL WATER LEVEL BELOW REF. l_i (ft.) <u>5.42 TOC</u>	TESTED BY: <u>RHO</u>	
CLOCK TIME	ELAPSED TIME (t) Units: <u>min</u>	WATER LEVEL BELOW REF. AT TIME $t(l_t)$ (Ft)	HEAD AT TIME $t(h_t)$ $h_t = l_t - l_i$	HEAD RATIO h_t/h_o	REMARKS
<u>13:00</u>	<u>13.25</u>	<u>8.17</u>			
<u>14:00</u>	<u>14.25</u>	<u>7.85</u>	<u>2.43</u>	<u>.23</u>	
<u>16:00</u>	<u>16.25</u>	<u>7.33</u>			
<u>18:00</u>	<u>18.25</u>	<u>6.62</u>	<u>1.20</u>	<u>.11</u>	
<u>20:00</u>	<u>20.25</u>	<u>6.58</u>			
<u>23:15</u>	<u>23.50</u>	<u>6.18</u>	<u>1.76</u>		
<u>27:00</u>	<u>27.25</u>	<u>5.84</u>			
<u>30:00</u>	<u>30.25</u>	<u>5.68</u>			

AR001828

FIELD DATA SHEET IN-SITU HYDRAULIC CONDUCTIVITY TEST

PROJECT NUMBER AND CLIENT NAME ARMY COR 0285-23-1		LOCATION MILLCREEK	DATE OF TEST 5/20/88	WELL NUMBER MW-28B	
TEST TYPE RISING HEAD	TEST METHOD (EQUIP.) BAILED		INITIAL WATER LEVEL BELOW REF. l_i (ft.) 5.10 TOC	TESTED BY: RHO	
CLOCK TIME	ELAPSED TIME (t) Units: <u>min</u>	WATER LEVEL BELOW REF. AT TIME $t(t_t)$ (Ft)	HEAD AT TIME $t(h_t)$ $h_t = l_t - l_i$	HEAD RATIO h_t/h_o	REMARKS
10:40:30	0	11.10	6.00	1.0	
41:00	.50	9.92	4.82	.80	
41:15	.75	9.45	4.35	.73	
41:30	1.00	9.05	3.95	.66	
42:00	1.50	8.40	3.30	.55	
42:30	2.0	7.85	2.75	.46	
43:00	2.50	7.37	2.27	.38	
43:30	3.00	7.00	1.90	.32	
44:00	3.50	6.68	1.58	.26	
44:30	4.00	6.42	1.32	.22	
45:00	4.50	6.18	1.08	.18	
45:35	5.00	6.00	.90	.15	
46:00	5.50	5.87	.77	.13	
46:30	6.00	5.74	.64	.11	
47:00	6.50	5.65	.55	.09	
47:30	7.00	5.55			
48:00	7.50	5.47			
48:30	8.00	5.42			
AR001829					

$$D = \text{ELEV(WATER LEVEL)} - \text{ELEV(BASE OF AQUIFER)}$$

$$= H$$

$$H = \text{ELEV(WATER LEVEL)} - \text{ELEV(BASE OF WELL)}$$

$$= 20.5 - 0.3 - 8.80 = 11.40'$$

$$r_w = \text{BOREHOLE } \phi = 0.5'$$

$$L = \text{SCREEN LENGTH (OR SATURATED SCREENED INTERVAL IF SMALLER)}$$

$$= 20.0 - 8.0 - 1.1' = 10.90$$

* NON-SAT. PORTION OF SAND PACK

$$r_c = \text{WELL } \phi = 0.167'$$

$$y_0 = \text{INITIAL DRAWDOWN} = 4.50'$$

$$y_t = \text{DRAWDOWN AT TIME (t)} = 0.55'$$


$$t = \text{TIME t min} = 4.2$$

$$L/r_w = 21.80$$

$$A =$$

$$B =$$

$$C = 1.90$$

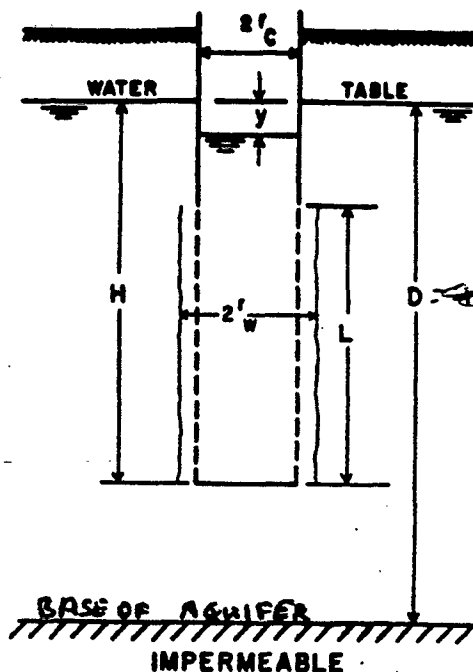


$$\ln \frac{R_e}{r_w} = \left[\frac{1.1}{\ln H/r_w} + \frac{A + B \ln[(D-H)/r_w]}{L/r_w} \right]^{-1}$$

$$\ln \frac{R_e}{r_w} = \left(\frac{1.1}{\ln H/r_w} + \frac{C}{L/r_w} \right)^{-1} = \left(\frac{1.1}{3.1268} + \frac{1.90}{21.80} \right)^{-1} = 2.2781$$

$$K = \frac{r_c^2 \ln(R_e/r_w)}{2L} \left(\frac{1}{t} \right) \ln \frac{y_0}{y_t} = \frac{(0.167)^2 (2.2781)}{2 (10.90)} \cdot \frac{1}{4.2} \ln \frac{4.50}{0.55}$$

$$= 1.4585 \times 10^{-3} \frac{\text{ft}}{\text{min}} \times \frac{12 \text{ in}}{\text{ft}} \times \frac{2.54 \text{ cm}}{\text{in}} \times \frac{1 \text{ min}}{60 \text{ sec}} = 7.4 \times 10^{-4} \frac{\text{cm}}{\text{sec}}$$

AR001830

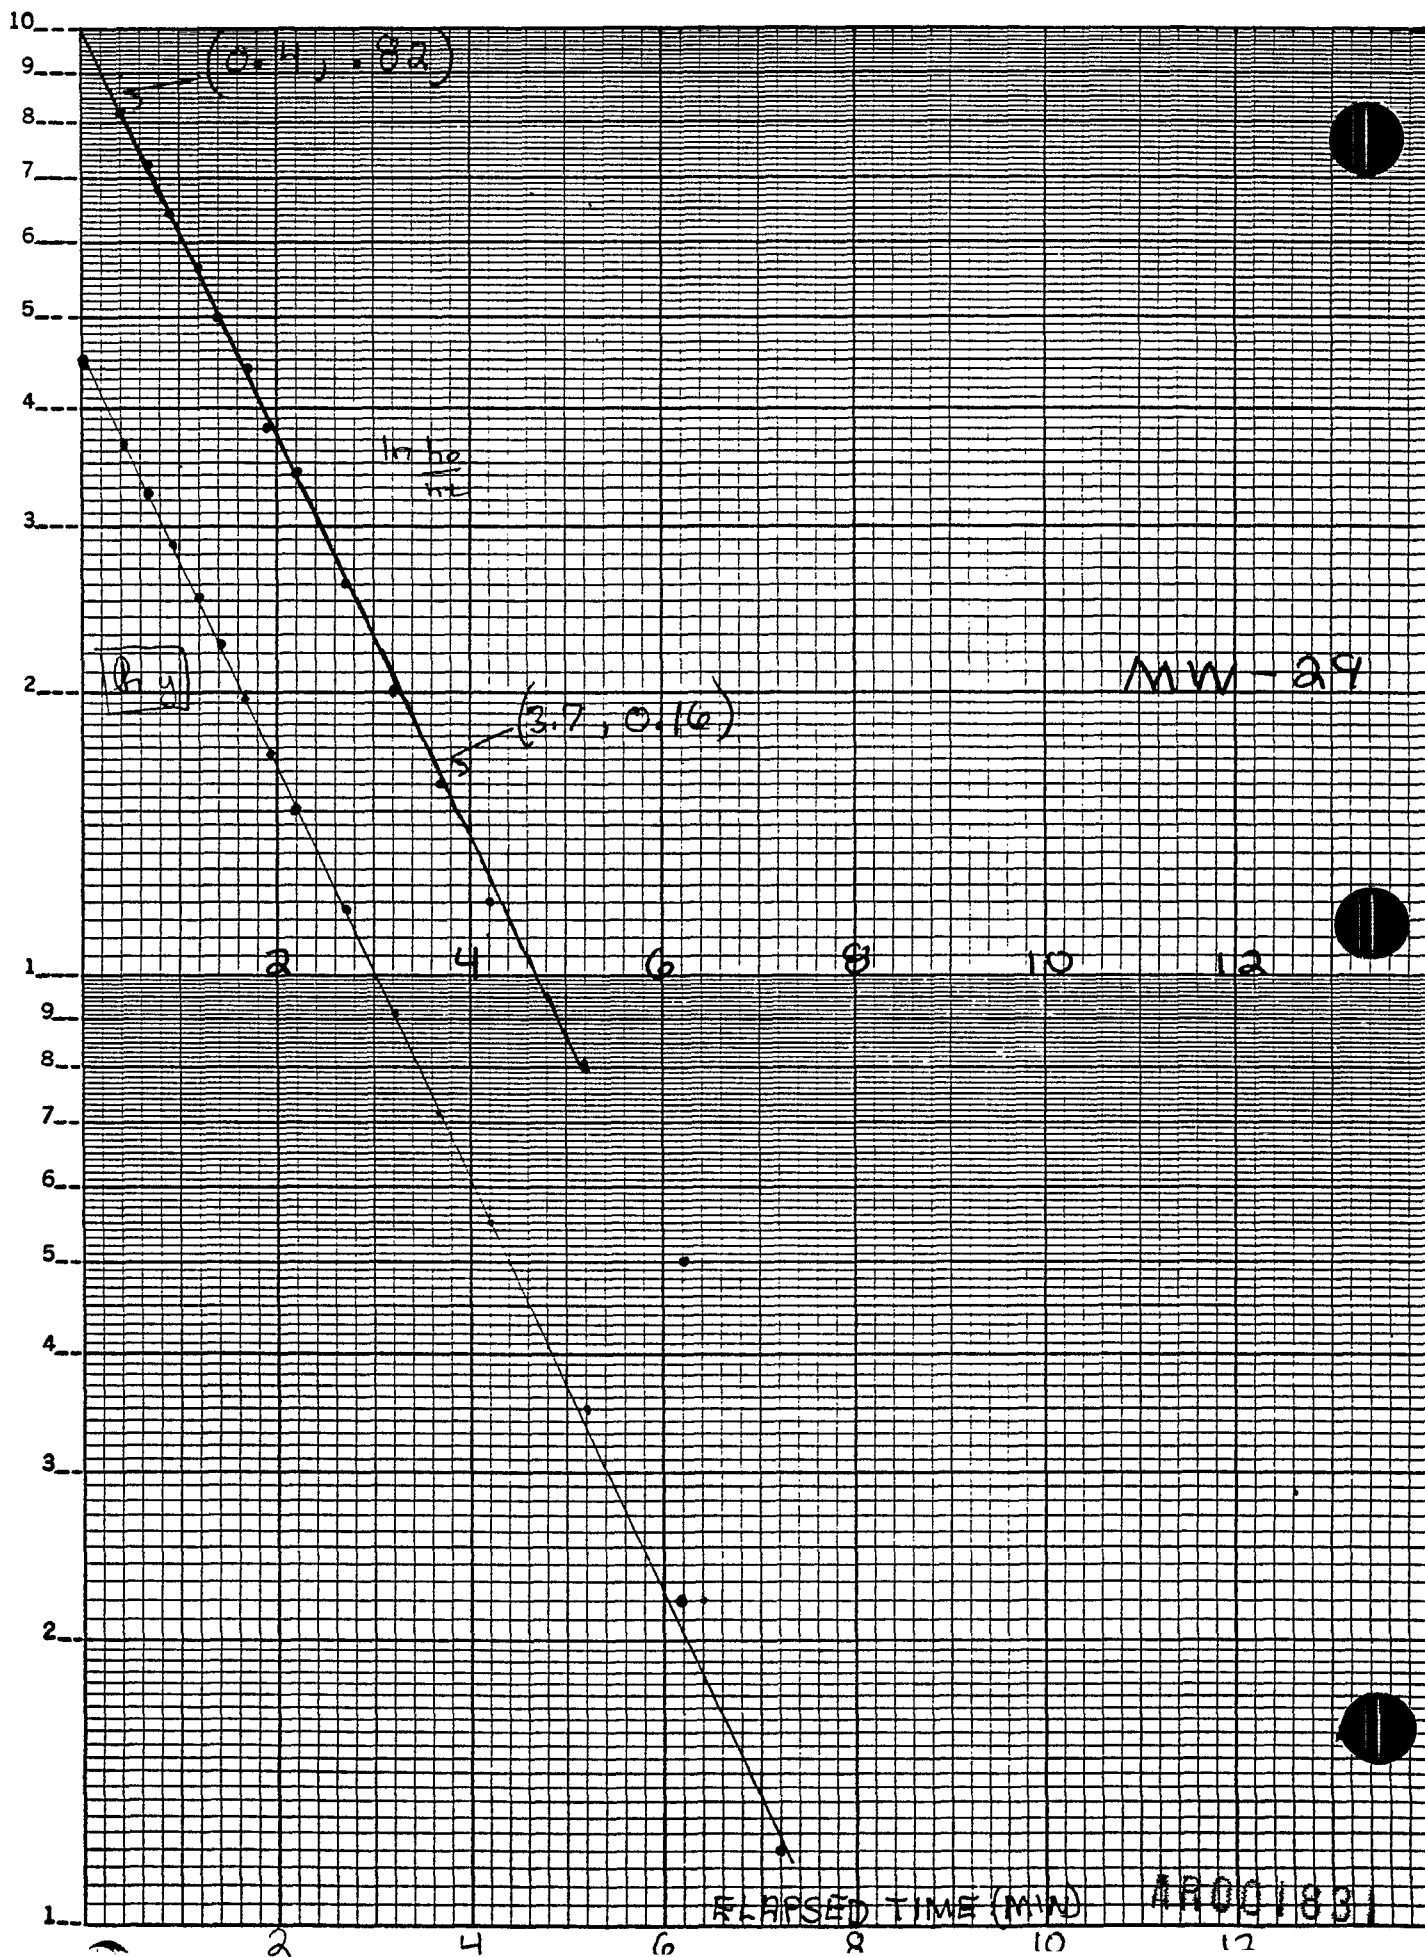

FIELD DATA SHEET

IN SITU HYDRAULIC CONDUCTIVITY TEST

ORIGINAL
(RED)

PROJECT NUMBER AND CLIENT NAME Millcreek		LOCATION Fire, PA	DATE OF TEST 5/31/88	WELL NAME 29
TEST TYPE Rising Head	TEST METHOD (EQUIP) Bail Sgal	INITIAL WATER LEVEL BELOW REF. l_i (ft) 8.80 TOC		TESTED BY RHO

LOCK TIME	ELAPSED TIME (min)	WATER LEVEL BELOW REF. AT TIME t (l_t) (ft)	HEAD AT TIME t (h_t) $h_t = l_t - l_i$	Head Ratio h_t/h_o	REMARKS
2:42:50	0	13.30	4.50		
43:15	.42	12.47	3.67		
43:30	.67	12.04	3.24		
43:45	.92	11.67	2.87		
44:00	1.17	11.32	2.52		
44:15	1.42	11.05	2.25		
44:30	1.67	10.77	1.97		
44:45	1.92	10.52	1.72		
45:00	2.17	10.32	1.52		
45:30	2.67	9.98	1.18		
46:00	3.17	9.72	0.92		
46:30	3.67	9.52	0.72		
47:00	4.17	9.35	0.55		
48:00	5.17	9.15	0.35		
49:00	6.17	9.02	0.22		
50:00	7.17	8.92	0.12		
52:00	9.17	8.86	0.06		
56:00	13.17	8.82	0.02		
1:00:00		8.82			

AR001832

ORIGINAL
(RED)

44 VARIABLE HEAD PERMEABILITY TEST

PROJECT NAME: MILLCREEK

PROJECT NUMBER: 0298-23-1

DATE TESTED: 5-31-88

WELL NUMBER: MW-22

INITIAL WATER LEVEL (L1): 8.8 FT TOC

ELAPSED TIME (MIN)	WATER LEVEL AT TIME t (Lt) (FT)	HEAD AT TIME t (Ht) Ht = Lt (FT)	HEAD RATIO Ht/Ho
0.0	13.30	4.5	1.00
0.4	12.47	3.7	0.82
0.7	12.04	3.2	0.72
0.9	11.67	2.9	0.64
1.2	11.32	2.5	0.56
1.4	11.05	2.3	0.50
1.7	10.77	2.0	0.44
1.9	10.52	1.7	0.38
2.2	10.32	1.5	0.34
2.7	9.98	1.2	0.26
3.2	9.72	0.9	0.20
3.7	9.52	0.7	0.16
4.2	9.35	0.6	0.12
5.2	9.15	0.3	0.08
6.2	9.02	0.2	0.05
7.2	8.92	0.1	0.03
9.2	8.86	0.1	0.01
13.2	8.82	0.0	0.00

WELL RADIUS (r) = 2 INCHES

SAND PACK RADIUS (R) = 6 INCHES

LENGTH OF SAND PACK (L) = 12.5 FT

FIRST HEAD RATIO (H1) 0.82

ELAPSED TIME IN MINUTES (T1) 0.4

SECOND HEAD RATIO (H2) 0.16

ELAPSED TIME IN MINUTES (T2) 3.7

$$K = \frac{r^2 * \ln (L/R) * \ln (H1/H2)}{2 (L) * (T2 - T1) * 60 \text{ SEC/MIN}}$$

** K = 8.997011E-04 CM/SEC **

NOTE: DATA IS CONVERTED FROM ENGLISH TO METRIC UNITS

AR001833

ORIGINAL
(RED)

$$D = \text{ELEV(WATER LEVEL)} - \text{ELEV(BASE OF AQUIFER)}$$

$$= 22.8 - 0.30 - 4.85 = 17.65'$$


$$H = \text{ELEV(WATER LEVEL)} - \text{ELEV(BASE OF WEL)} - 4.85$$

$$= 20.5 - 0.30 - 4.85 = 15.35'$$

$$r_w = \text{BOREHOLE } \phi = 0.5'$$

$$L = \text{SCREEN LENGTH (OR SATURATED SCREENED INTERVAL IF SMALLER)}$$

$$= 20.5 - 6.0 = 14.50'$$

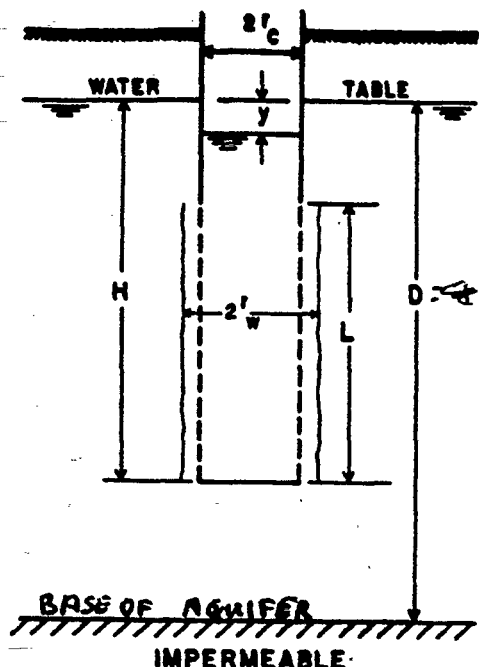

$$r_c = \text{WELL } \phi = 0.167'$$

$$y_0 = \text{INITIAL DRAWDOWN} = 5.55'$$

$$y_t = \text{DRAWDOWN AT TIME (t)} = 0.62'$$

$$t = \text{TIME t min} = 5.50$$

$$L/r_w = 29.00$$

$$A = 2.20$$

$$B = 1.37$$

$$C =$$

$$\ln \frac{R_e}{r_w} = \left[\frac{1.1}{\ln H/r_w} + \frac{A + B \ln[(D-H)/r_w]}{L/r_w} \right]^{-1}$$


$$= \left(\frac{1.1}{3.4243} + \frac{2.20 + 1.37(1.5261)}{29.0} \right)^{-1} = 2.1311$$

$$\ln \frac{R_e}{r_w} = \left(\frac{1.1}{\ln H/r_w} + \frac{C}{L/r_w} \right)^{-1}$$

$$K = \frac{r_c^2 \ln(R_e/r_w)}{2L} \left(\frac{1}{t} \right) \ln \frac{y_0}{y_t} = \frac{(0.167)^2 (2.1311)}{2 (14.50)} \cdot \frac{1}{5.5 \text{ min}} \cdot \ln \frac{5.55}{0.62}$$

$$= 8.1624 \times 10^{-4} \frac{\text{ft}}{\text{min}} \times \frac{12 \text{ in}}{\text{ft}} \times \frac{2.54 \text{ cm}}{\text{in}} \times \frac{1 \text{ min}}{60 \text{ sec}} = 4.1 \times 10^{-4} \frac{\text{cm}}{\text{sec}}$$

APR001834

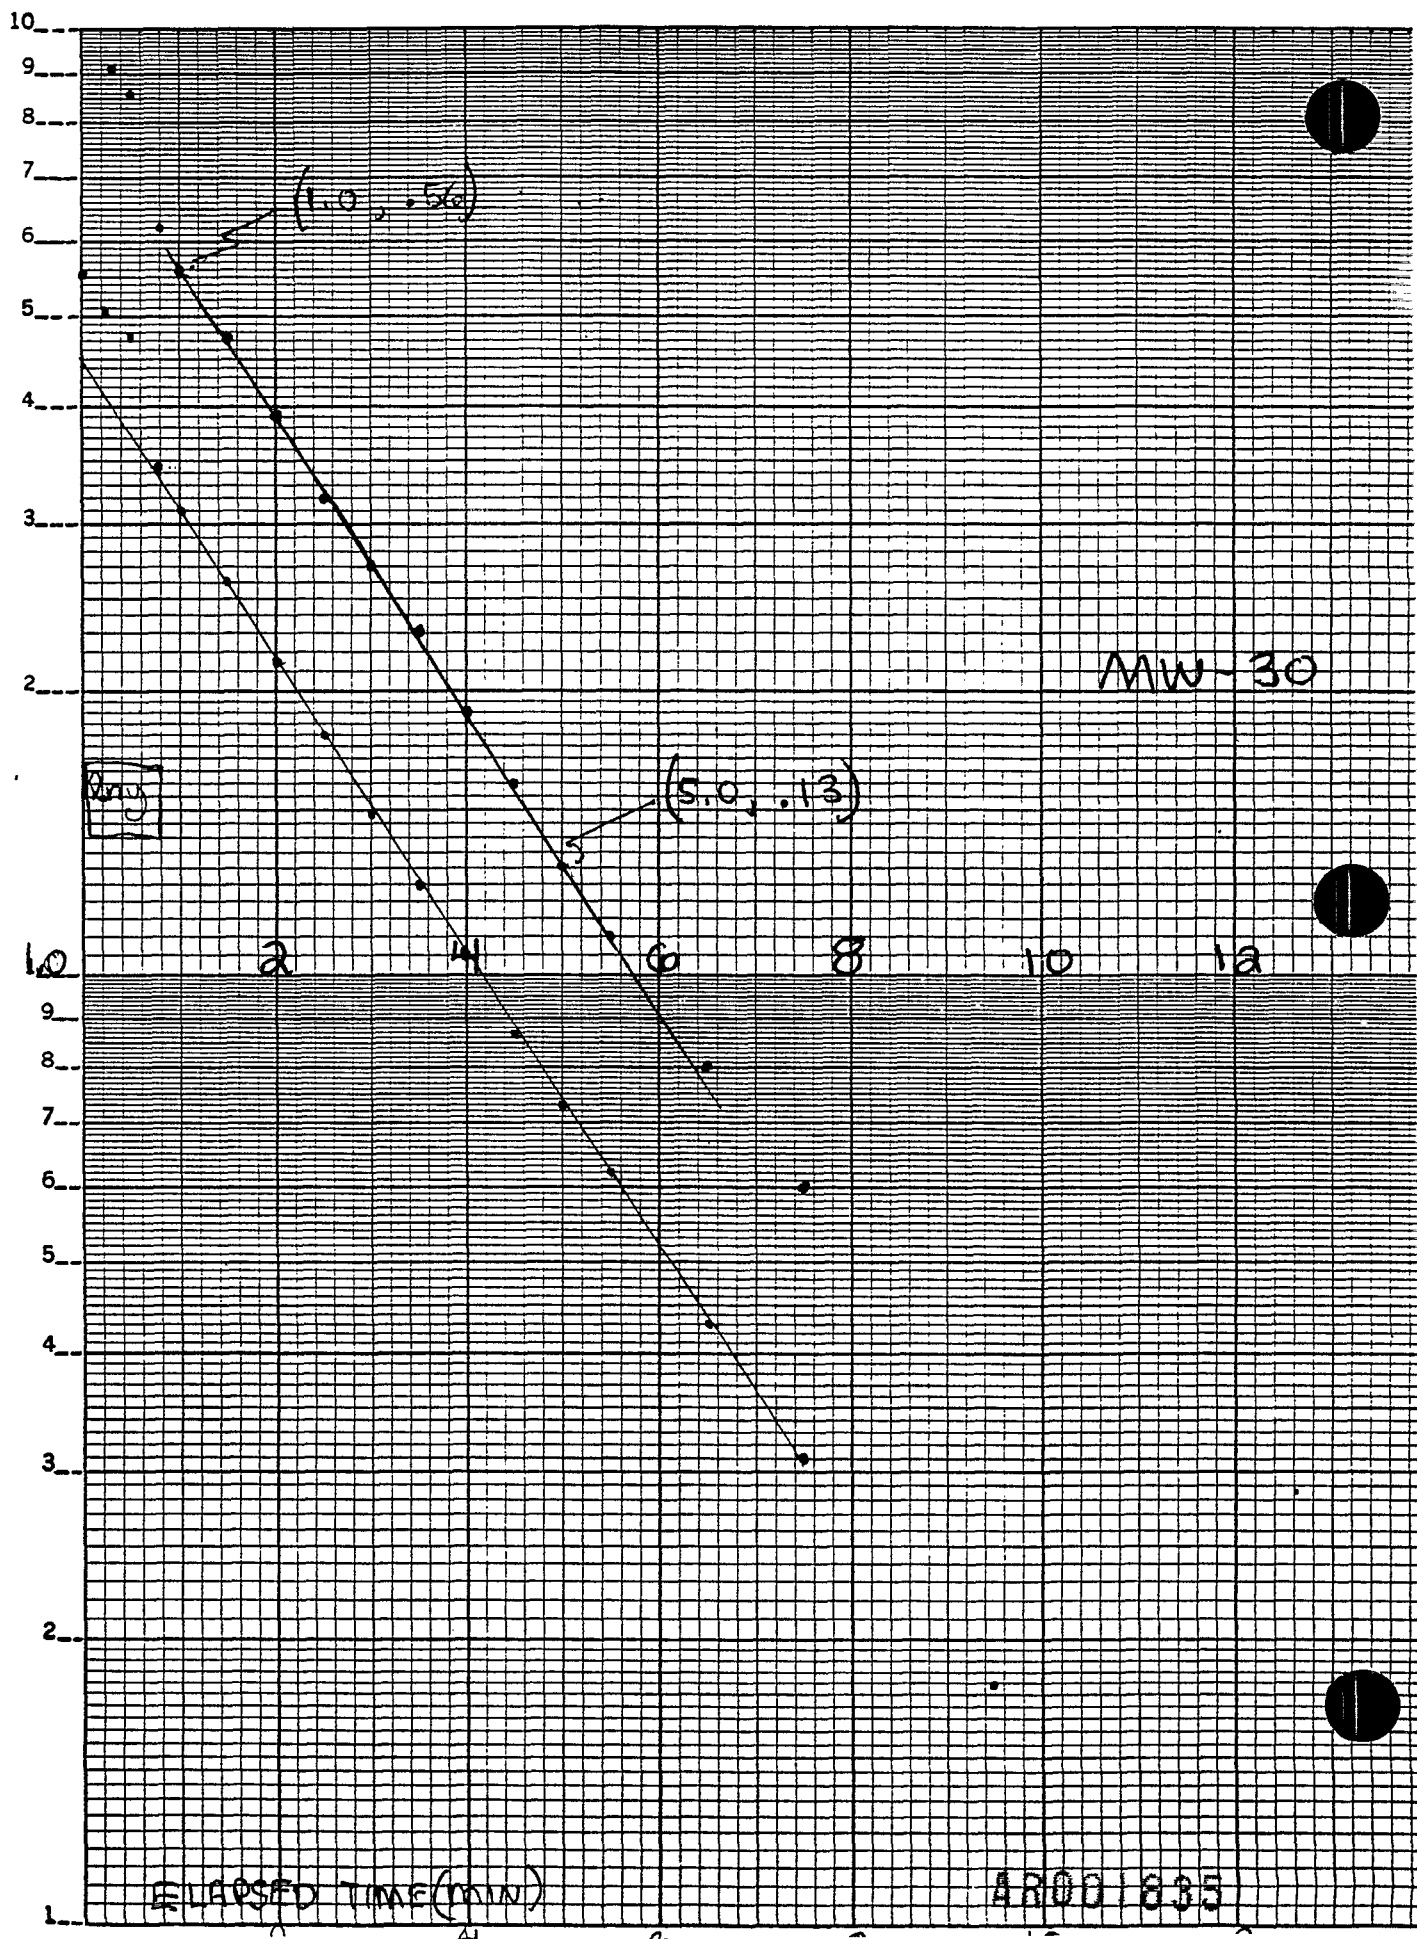

FIELD DATA SHEET

IN SITU HYDRAULIC CONDUCTIVITY TEST

OR (REL)

PROJECT NUMBER AND CLIENT NAME Miller Creek		LOCATION Eliz., PA	DATE OF TEST 5/31/88	WELL NUMB 30
TEST TYPE Rising Head	TEST METHOD (EQUIP.) Bail Sgal	INITIAL WATER LEVEL BELOW REF. l_i (ft) 4.85' TOC		TESTED BY RHO

CLOCK TIME	ELAPSED TIME (min)	WATER LEVEL BELOW REF. AT TIME t (l _t) (ft)	HEAD AT TIME t (h _t) h _t = l _t - l _i	Head Ratio h _t /h ₀	REMARKS
2:19:30	0	10.4	5.55		
19:45	.25	9.9	5.05		
20:00	.50	9.6	4.75		
20:15	.75	8.3	3.45		
20:30	1.00	7.95	3.10		
21:00	1.50	7.44	2.59		
21:30	2.00	7.0	2.15		
22:00	2.50	6.65	1.80		
22:30	3.00	6.33	1.48		
23:00	3.50	6.10	1.25		
23:30	4.00	5.90	1.05		
24:00	4.50	5.72	0.87		
24:30	5.00	5.58	0.73		
25:00	5.50	5.47	0.62		
26:00	6.50	5.28	0.43		
27:00	7.50	5.16	0.31		
29:00	9.50	5.03	0.18		

AR001836

** VARIABLE HEAD PERMEABILITY TEST **

PROJECT NAME: MILLCREEK

PROJECT NUMBER: 0255-23-0

DATE TESTED: 5-31-88

WELL NUMBER: MW-30

INITIAL WATER LEVEL (L1): 4.65 FT TDC

ELAPSED TIME (MIN)	WATER LEVEL AT TIME t (Lt) (FT)	HEAD AT TIME t (Ht) Ht = Lt (FT)	HEAD RATIO Ht/Ho
0.0	10.40	5.5	1.00
0.3	9.90	5.0	0.91
0.5	9.60	4.8	0.86
0.8	8.30	3.5	0.62
1.0	7.95	3.1	0.56
1.5	7.44	2.6	0.47
2.0	7.00	2.2	0.39
2.5	6.65	1.8	0.32
3.0	6.33	1.5	0.27
3.5	6.10	1.3	0.23
4.0	5.90	1.1	0.19
4.5	5.72	0.9	0.16
5.0	5.58	0.7	0.13
5.5	5.47	0.6	0.11
6.5	5.28	0.4	0.08
7.5	5.16	0.3	0.06
7.5	5.03	0.2	0.03

WELL RADIUS (r) = 2 INCHES

SAND PACK RADIUS (R) = 6 INCHES

LENGTH OF SAND PACK (L) = 14.5 FT

FIRST HEAD RATIO (H1) 0.56

ELAPSED TIME IN MINUTES (T1)

1.0

SECOND HEAD RATIO (H2) 0.13

ELAPSED TIME IN MINUTES (T2)

5.0

$$K = \frac{r^2 * \ln (L/R) * \ln (H1/H2)}{2 (L) * (T2 - T1) * 60 \text{ SEC/MIN}}$$

** K = 5.982146E-04 CM/SEC **

NOTE: DATA IS CONVERTED FROM ENGLISH TO METRIC UNITS

AR001837

MW - 31 6-17-88

$$r_c = 2'' = .167'$$

$$r_w = 6'' = .5'$$

$$\text{SandPach Length } (L) = 19.40 - 6.0 = 13.40'$$

$$t_1: 7 \text{ sec} \quad H: 0.56$$

$$t_2: 29 \text{ sec} \quad H: 0.14$$

$$K = \frac{(r_c)^2 \ln(L/r_w)}{2(L)(t_2 - t_1)} \cdot \ln(H_1/H_2)$$

$$= \frac{(.167)^2 \ln(13.40/.5)}{2(13.40)(29-7)} \cdot \ln \frac{.56}{.14}$$

$$= \frac{(.167)^2 (3.2884)}{2(13.40)(29-7)} \cdot (1.3863) = .0002156 \text{ ft/sec}$$

$$- \times \frac{12 \text{ in}}{\text{ft}} \times \frac{2.54 \text{ cm}}{\text{in}} = 6.6 \times 10^{-3} \text{ cm/sec}$$

checked w/ computer - 5.558E-3

AVUABEL
MADE IN USA

DRAWING PAPER NO. 1371-21
TRACING PAPER NO. 1230-21
SEMI-LOG. 3 CY. BY 10 DIV./ IN.

lmg

10.4
1.6


MW-31

6-17-88

Bowyer-Rice

Huonslev

ELAPSED TIME (SEC) AR001839

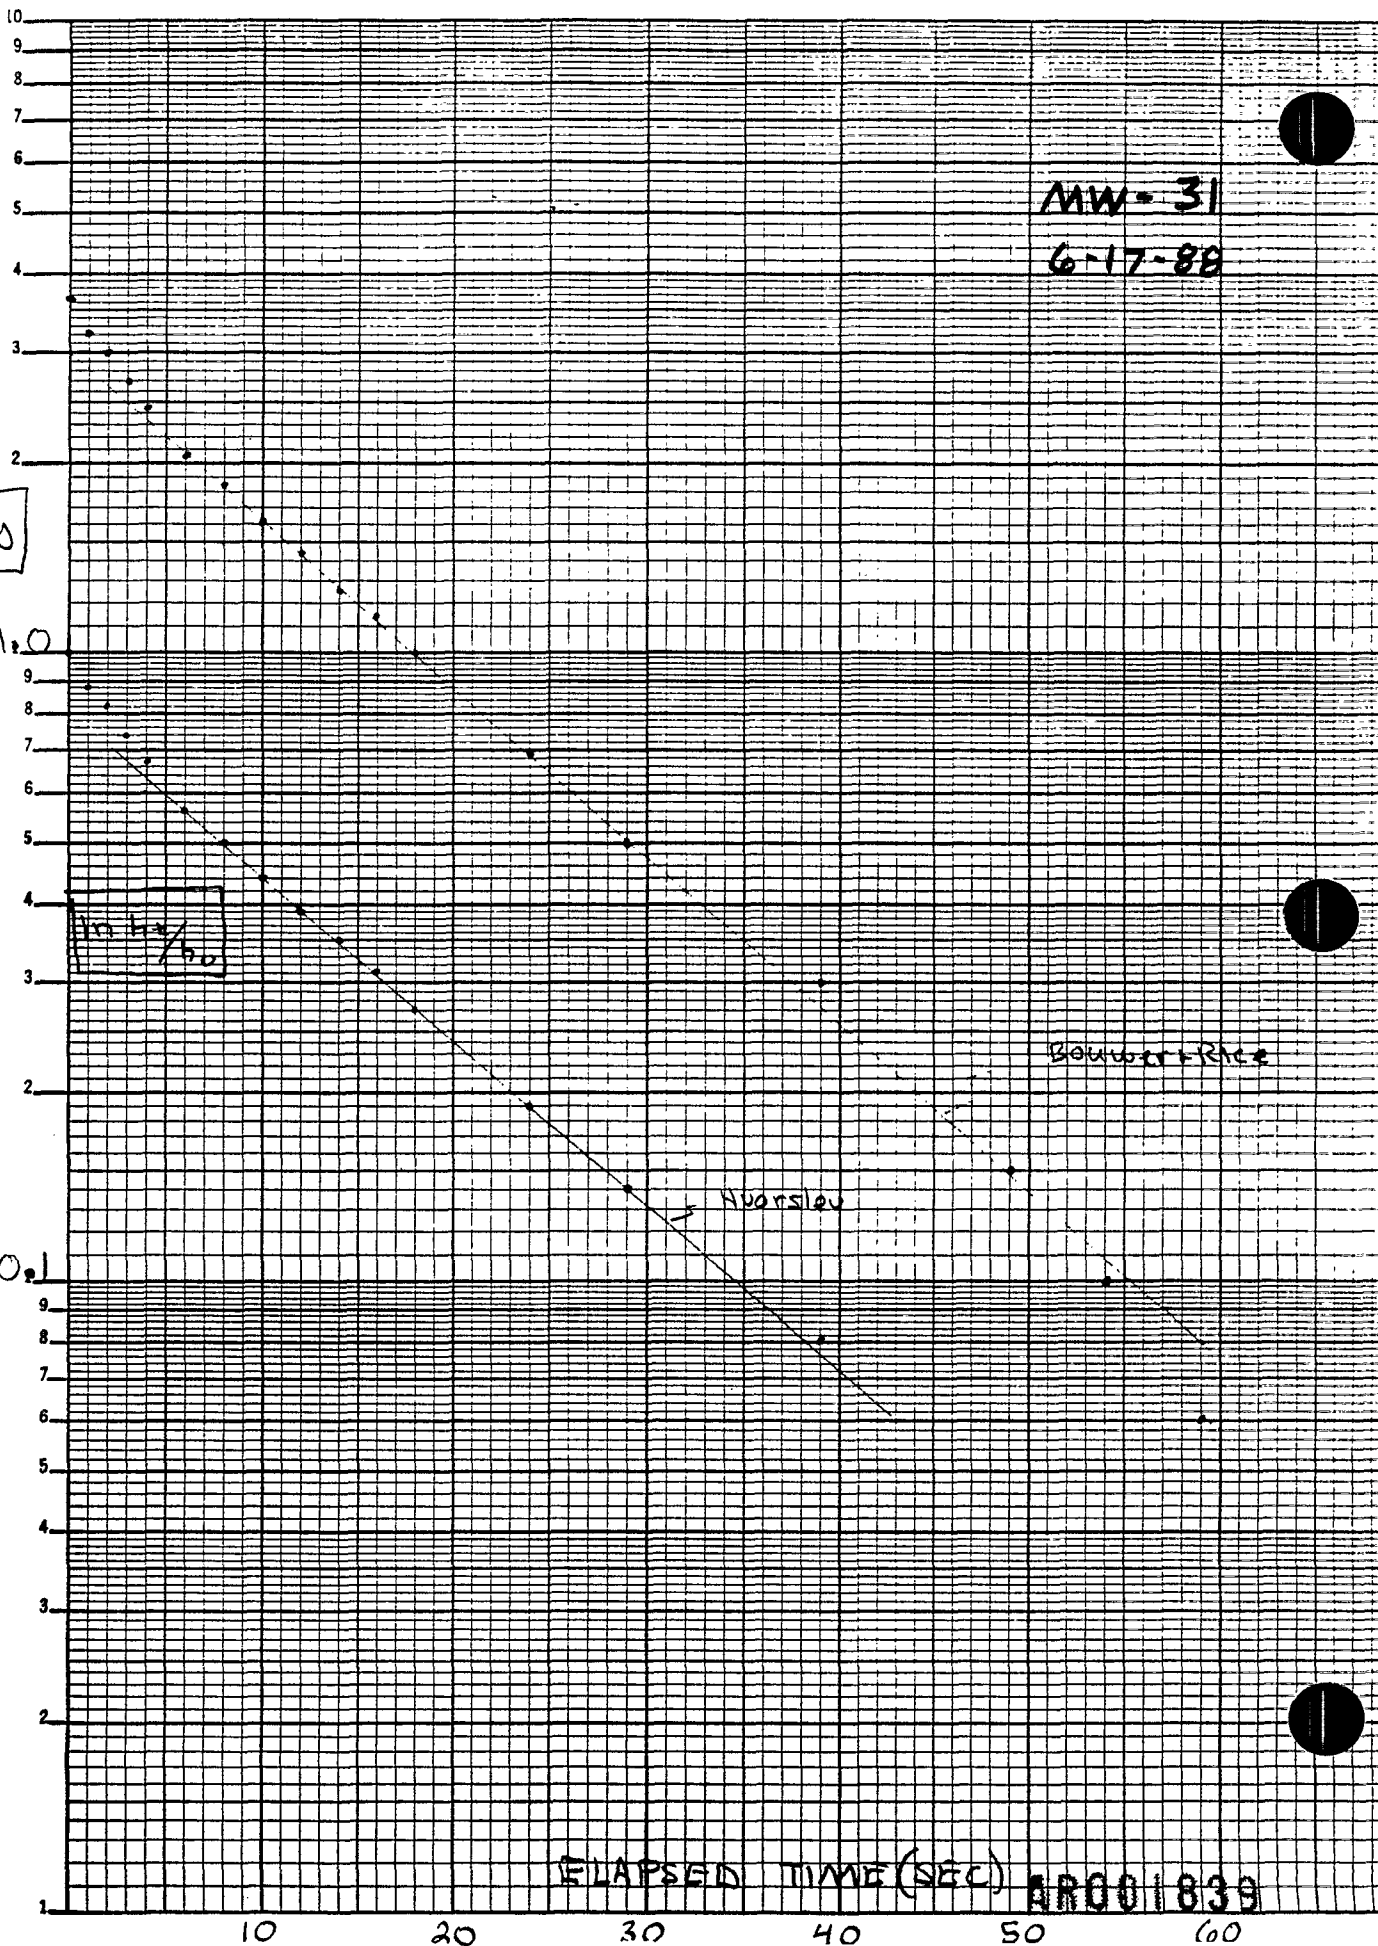

FIELD DATA SHEET

IN-SITU HYDRAULIC CONDUCTIVITY TEST

PROJECT NUMBER AND CLIENT NAME 0285-23-1 COE		LOCATION MILLCREEK	DATE OF TEST 6-17-88	WELL NUMBER 31	
TEST TYPE RISING HEAD	TEST METHOD (EQUIP.) 2" PVC SLUG & transducer		INITIAL WATER LEVEL BELOW REF. l_i (ft.) 4.71 TOC	TESTED BY: RHO	
CLOCK TIME	ELAPSED TIME (t) Units: <u>Sec</u>	WATER LEVEL BELOW REF. AT TIME $t(l_t)$ (Ft)	HEAD AT TIME $t(h_t)$ $h_t = l_t - l_i$	HEAD RATIO h_t/h_o	REMARKS
	0	8.36	3.65	1.0	
	0.2	8.16			
	0.4	8.09			
	0.6	8.04			
	1.0	7.93	3.22	.88	
	2.0	7.70	2.99	.82	
	3.0	7.42	2.71	.74	
	4.0	7.17	2.46	.67	
	5.0	6.94			
	6.0	6.77	2.06	.56	
	7.0	6.67			
	8.0	6.55	1.84	.50	
	9.0	6.43			
	10.0	6.32	1.61	.44	
	11.0	6.24			
	12.0	6.14	1.43	.39	
	13.0	6.05			
	14.0	5.98	1.27	.35	
	15.0	5.91			
	16.0	5.84	1.13	.31	
	17.0	5.77			
	18.0	5.71	1.00	.27	
	19.0	5.65			
	24.0	5.40	0.69	.19	
	29.0	5.21	0.50	.14	

14R001840

FIELD DATA SHEET
IN-SITU HYDRAULIC CONDUCTIVITY TEST

PROJECT NUMBER AND CLIENT NAME <u>0285-23-1</u>		LOCATION <u>MILL CREEK</u>	DATE OF TEST <u>6-17-88</u>	WELL NUMBER <u>31</u>	
TEST TYPE	TEST METHOD (EQUIP.)		INITIAL WATER LEVEL BELOW REF. l_i (ft.) <u>4.71 TOC</u>	TESTED BY:	
CLOCK TIME	ELAPSED TIME (t) Units: <u>Sec</u>	WATER LEVEL BELOW REF. AT TIME $t(l_t)$ (Ft)	HEAD AT TIME $t(h_t)$ $h_t = l_t - l_i$	HEAD RATIO h_t/h_o	REMARKS
	34	5.11			
	39	5.01	0.30	.08	
	44	4.93			
	49	4.86	0.15		
	54	4.81	0.10		
	59	4.77	0.06		
	64	4.73	0.02		
	69	4.71	0		


AR001841

$$D = \text{ELEV(WATER LEVEL)} - \text{ELEV(BASE OF AQUIFER)} \\ = 22.0 - 0.32 - 5.97 = 15.70'$$

$$H = \text{ELEV(WATER LEVEL)} - \text{ELEV(BASE OF WELL)} \\ = 20.5 - 0.32 - 5.97 = 14.21'$$

$$r_w = \text{BOREHOLE } \phi = 0.5'$$

$$L = \text{SCREEN LENGTH (OR SATURATED SCREENED INTERVAL IF SMALLER)} \\ = 20.5 - 8.7 = 11.80'$$

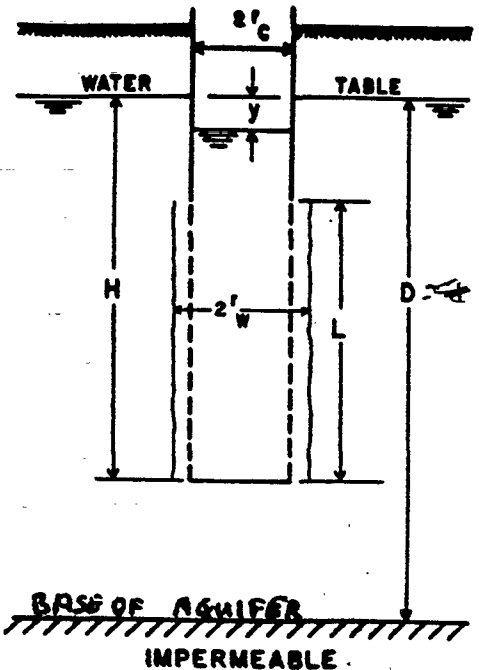

$$r_c = \text{WELL } \phi = 0.107'$$

$$y_0 = \text{INITIAL DRAWDOWN} = 4.40'$$

$$y_t = \text{DRAWDOWN AT TIME (t)} = 0.20'$$

$$t = \text{TIME t SEC} = 66$$

$L/r_w =$	23.60	* Assumes f/v for lacustrine sands because at 22 ft as one would extrapolate from MW-35 and MW-31
A	2.20	
B	1.37	
C		

$$\ln \frac{R_e}{r_w} = \left[\frac{1.01}{\ln H/r_w} + \frac{A + B \ln[(D-H)/r_w]}{L/r_w} \right]^{-1} \\ = \left(\frac{1.01}{3.3471} + \frac{2.20 + 1.37 (1.0986)}{23.60} \right)^{-1} = 2.0593$$

$$\ln \frac{R_e}{r_w} = \left(\frac{1.01}{\ln H/r_w} + \frac{C}{L/r_w} \right)^{-1}$$

$$K = \frac{r_c^2 \ln(R_e/r_w)}{2L} \left(\frac{1}{t} \right) \ln \frac{y_0}{y_t} = \frac{(0.107)^2 (2.0593)}{2 (11.80)} \cdot \frac{1}{66 \text{ sec}} \cdot \ln \frac{4.40}{0.20}$$

$$= 1.1397 \times 10^{-4} \frac{\text{ft}}{\text{sec}} \times \frac{12 \text{ in}}{\text{ft}} \times \frac{2.54 \text{ cm}}{\text{in}} = 3.5 \times 10^{-3} \frac{\text{cm}}{\text{sec}}$$


AR001842

AQUABEL

MADE IN USA

DRAWING PAPER NO. 1371-21
TRACING PAPER NO. 1230-21
SEMI-LOG. 3 CY. BY 10 DIV./ IN.

lny

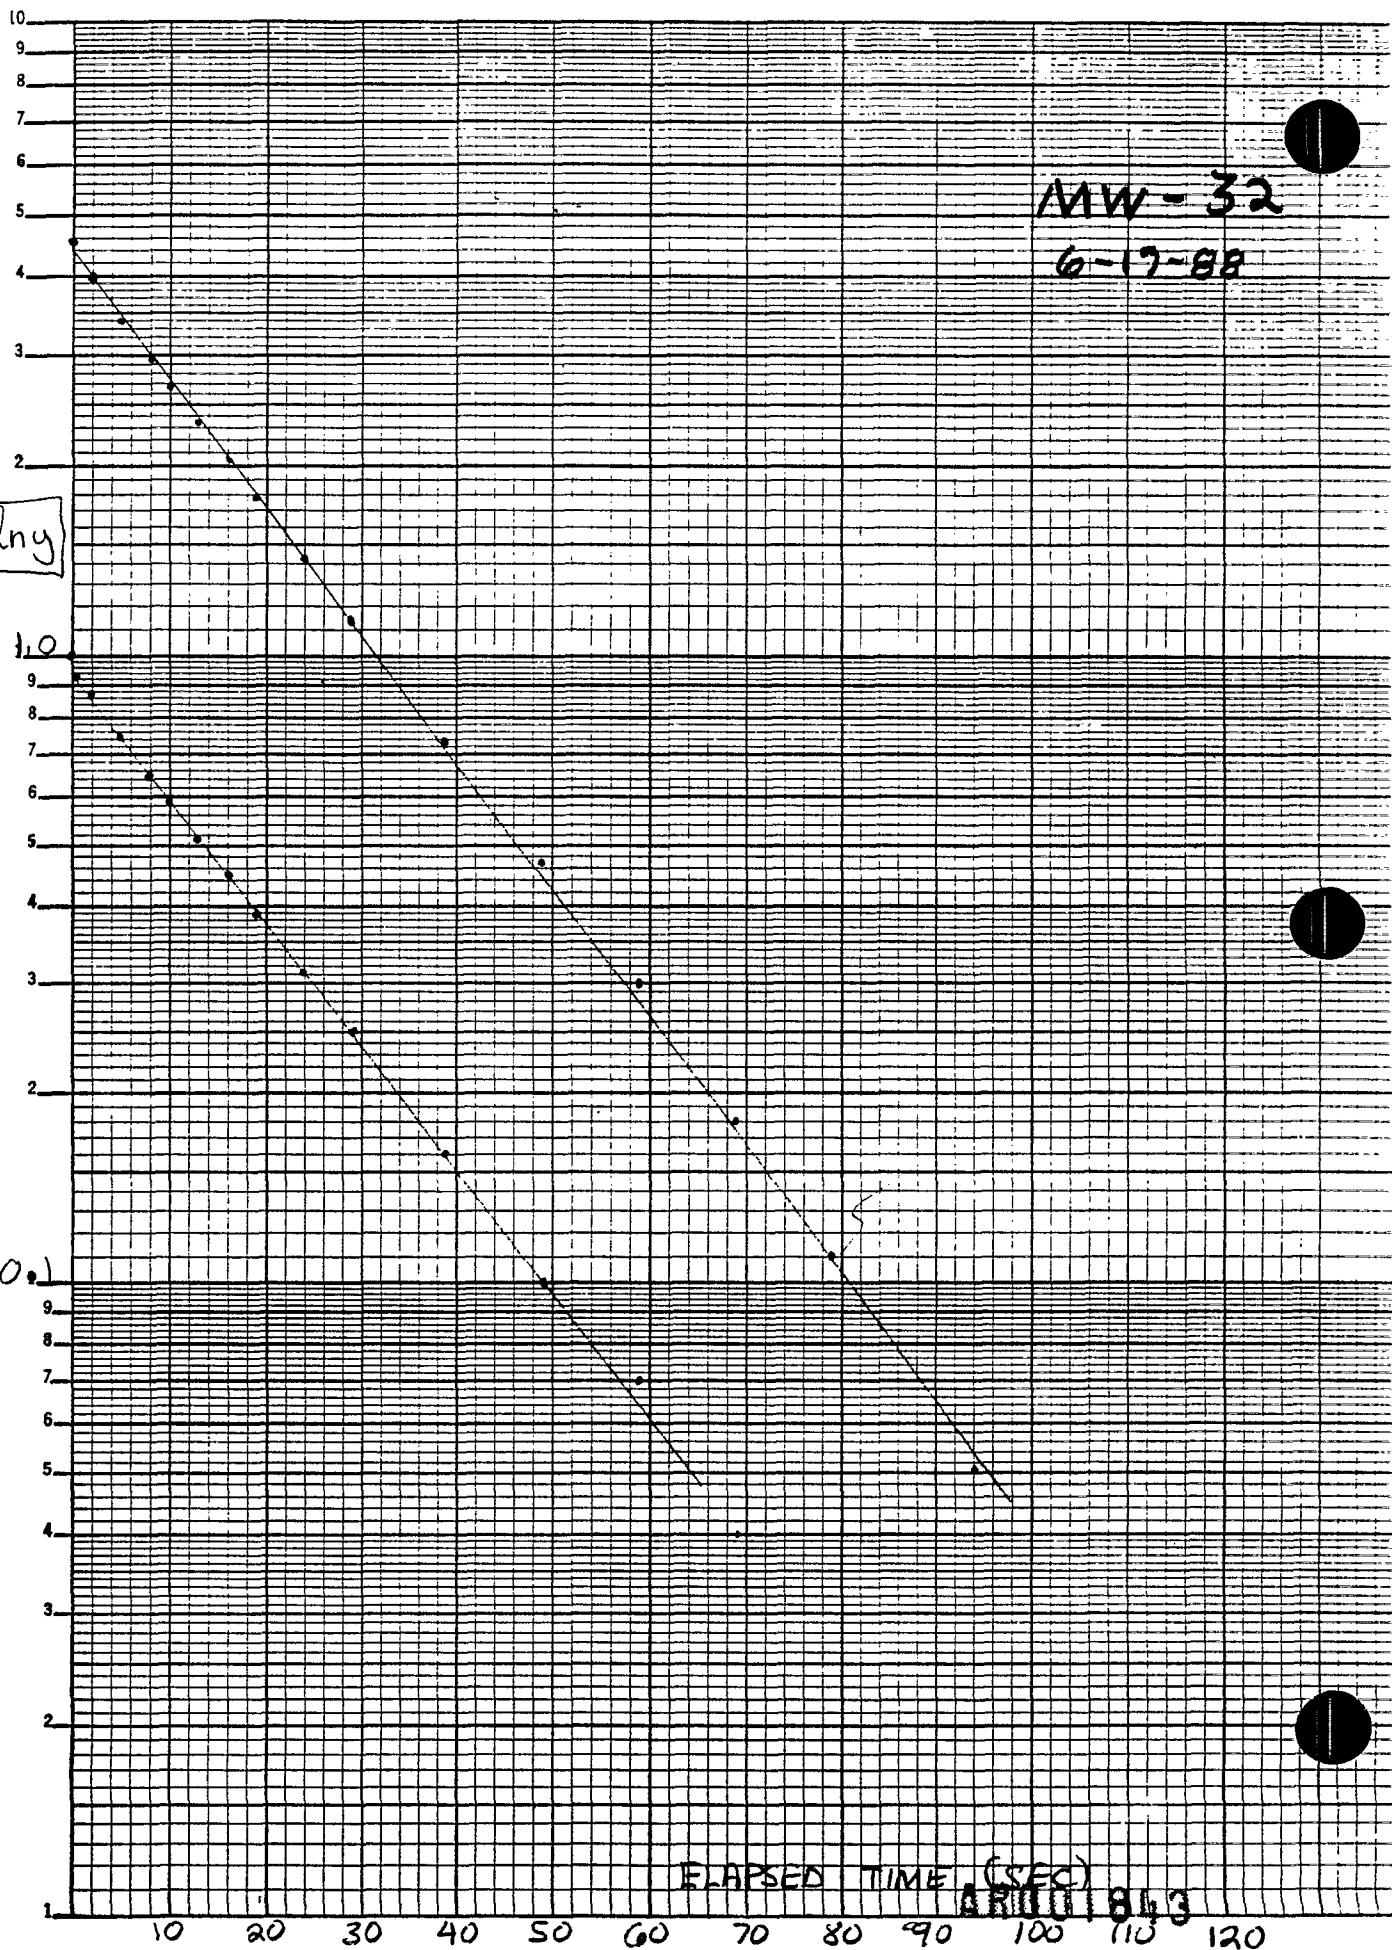

IN-SITU HYDRAULIC CONDUCTIVITY TEST

[illegible]

Method Not Used

$$D = \text{ELEV. (WATER LEVEL)} - \text{ELEV. (BASE OF AQUIFER)}$$

II *

11

$$H = \text{ELEV}(\text{WATER LEVEL}) - \text{ELEV}(\text{BASE OF WGU})$$

$$= 20.5 - 0.32 - 5.97 = 14.21$$

11

$r_w = \text{BOREHOLE } \phi = 0.5'$

L = SCREEN LENGTH (OR SATURATED

SCREENED INTERVAL IF SMALLER

$$= 20.5 - 8.7 = 11.80'$$

$$r_c = \text{WELL} = 0.165'$$

$$y_0 = \text{INITIAL DRAWDOWN} = 4.40'$$

$$y_t = \text{DRAWDOWN AT TIME } (t) = 0.20'$$

$$t = \text{TIME } t \text{ SEC} = 66$$

$$L/r_w = 23.60$$

$$A =$$

B =

$$C = 1.90$$

* NO $\frac{f}{v}$ radius
sands where logs
to 22 ft. $\therefore$
D. maybe $> t$

$$\ln \frac{Re}{r_w} = \left[\frac{1.0}{\ln H/r_w} + \frac{A + B \ln[(D-H)/r_w]}{L/r_w} \right]^{-1}$$


$\approx 10^{-4}$ cm/sec seems 1
considering sands + gravel
logged during drilling &
results from other well
w/ abundant gravels.
 $\therefore$ use $D > H$

$$\ln \frac{Re}{rw} = \left(\frac{1.1}{\ln H/rw} + \frac{C}{L/rw} \right)^{-1} = \left(\frac{1.1}{3.3471} + \frac{1.90}{23.60} \right)^{-1} = .4091$$

$$K = \frac{r_c^2 \ln(R_e/r_n)}{2L} \left(\frac{1}{t} \right) \ln \frac{y_0}{y_t} = \frac{(1.67)^2 (4.091)}{2(11.80)} \cdot \frac{1}{66 \text{ sec}} \cdot \ln \frac{120}{120}$$

$$= 2.264 \times 10^{-5} \frac{\text{ft}}{\text{sec}} \times \frac{12 \text{ in}}{\text{ft}} \times \frac{2.54 \text{ cm}}{\text{in}} = 6.9 \times 10^{-4} \frac{\text{cm}}{\text{sec}}$$

AR001845

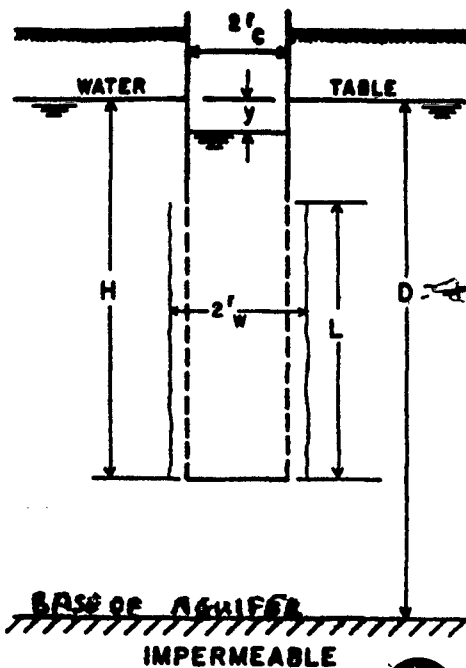

MW-32 6-17-88.. Horslev

$$r_c = .167$$

$$r_w = .5$$

$$L = 11.80'$$

$$t_1 = 10 \text{ sec} \quad H_1 = .59$$

$$t_L = 49 \text{ sec} \quad H_2 = .10$$

$$K = \frac{r_c^2 \ln \frac{L}{r_w}}{2L(t_L - t_1)} \cdot \ln \frac{H_1}{H_2}$$

$$= \frac{(.167)^2 (3.1612)}{2(11.80)(49-10)} \cdot (6.775) \cdot 0.001700 \text{ ft/sec}$$

$$\times \frac{12 \text{ in}}{\text{ft}} \times \frac{2.54 \text{ cm}}{\text{in}} = 5.2 \times 10^{-3} \text{ cm/sec}$$

checked w/ computer

** VARIABLE HEAD PERMEABILITY TEST **

PROJECT NAME: MILLCREEK

PROJECT NUMBER: 0285-23-1

DATE TESTED: 5-16-88

WELL NUMBER: MW-33A

INITIAL WATER LEVEL (L1): 7.9 FT TDC

ELAPSED TIME (MIN)	WATER LEVEL AT TIME t (Lt) (FT)	HEAD AT TIME t (Ht) Ht = Lt (FT)	HEAD RATIO Ht/Ho
0.0	13.90	6.0	1.00
0.5	12.80	4.9	0.82
1.0	12.00	4.1	0.68
1.5	11.30	3.4	0.57
2.0	10.75	2.8	0.48
2.5	10.30	2.4	0.40
3.0	9.95	2.0	0.34
3.5	9.60	1.7	0.28
4.0	9.35	1.5	0.24
4.5	9.10	1.2	0.20
5.0	8.95	1.0	0.17
5.5	8.78	0.9	0.15
6.0	8.64	0.7	0.12
6.5	8.55	0.7	0.11
7.0	8.45	0.5	0.09
7.5	8.38	0.5	0.08
9.0	8.22	0.3	0.05
10.0	8.15	0.2	0.04
12.0	8.05	0.2	0.03
14.0	7.99	0.1	0.01
16.0	7.96	0.1	0.01

WELL RADIUS (r) = 2 INCHES

SAND PACK RADIUS (R) = 6 INCHES

LENGTH OF SAND PACK (L) = 13.7 FT

FIRST HEAD RATIO (H1) 0.57

ELAPSED TIME IN MINUTES (T1)

1.5

SECOND HEAD RATIO (H2) 0.17

ELAPSED TIME IN MINUTES (T2)

5.0

$$K = \frac{r^2 * \ln (L/R) * \ln (H1/H2)}{2 (L) * (T2 - T1) * 60 \text{ SEC/MIN}}$$

** K = 5.893442E-04 CM/SEC **

NOTE: DATA IS CONVERTED FROM ENGLISH TO METRIC UNITS

AR001847

** VARIABLE HEAD PERMEABILITY TEST **

PROJECT NAME: MILLCREEK

PROJECT NUMBER: 7085-23-1

DATE TESTED: 3-16-88

WELL NUMBER: NW-33B

INITIAL WATER LEVEL (L1): 7.45 FT TOC

ELAPSED TIME (MIN)	WATER LEVEL AT TIME t (Lt) (FT)	HEAD AT TIME : (Ht) Ht = Lt (FT)	HEAD RATIO Ht/Ho
0.0	14.65	7.2	1.00
0.4	14.00	6.6	0.91
0.8	13.50	6.1	0.84
1.3	12.90	5.4	0.76
1.8	12.30	4.9	0.67
2.3	11.77	4.3	0.60
2.8	11.30	3.9	0.53
3.3	10.85	3.4	0.47
3.8	10.49	3.0	0.42
4.3	10.16	2.7	0.36
4.8	9.85	2.4	0.33
5.3	9.60	2.2	0.30
5.8	9.37	1.9	0.27
6.3	9.15	1.7	0.24
6.8	8.98	1.5	0.21
7.3	8.66	1.2	0.17
8.8	8.40	0.9	0.13
9.8	8.21	0.8	0.11
11.8	7.93	0.5	0.07
13.8	7.75	0.3	0.04
15.8	7.64	0.2	0.03

WELL RADIUS (r) = 2 INCHES

SAND PACK RADIUS (R) = 6 INCHES

LENGTH OF SAND PACK (L) = 8.1 FT 2.3'

FIRST HEAD RATIO (H1) 0.84 ELAPSED TIME IN MINUTES (T1) 0.8


SECOND HEAD RATIO (H2) 0.21 ELAPSED TIME IN MINUTES (T2) 6.8

$$K = \frac{r^2 * \ln(L/R) * \ln(H1/H2)}{2(L) * (T2 - T1) * 60 \text{ SEC/MIN}}$$

** K = 5.605022E-04 CM/SEC **

NOTE: DATA IS CONVERTED FROM ENGLISH TO METRIC UNITS

AR001848

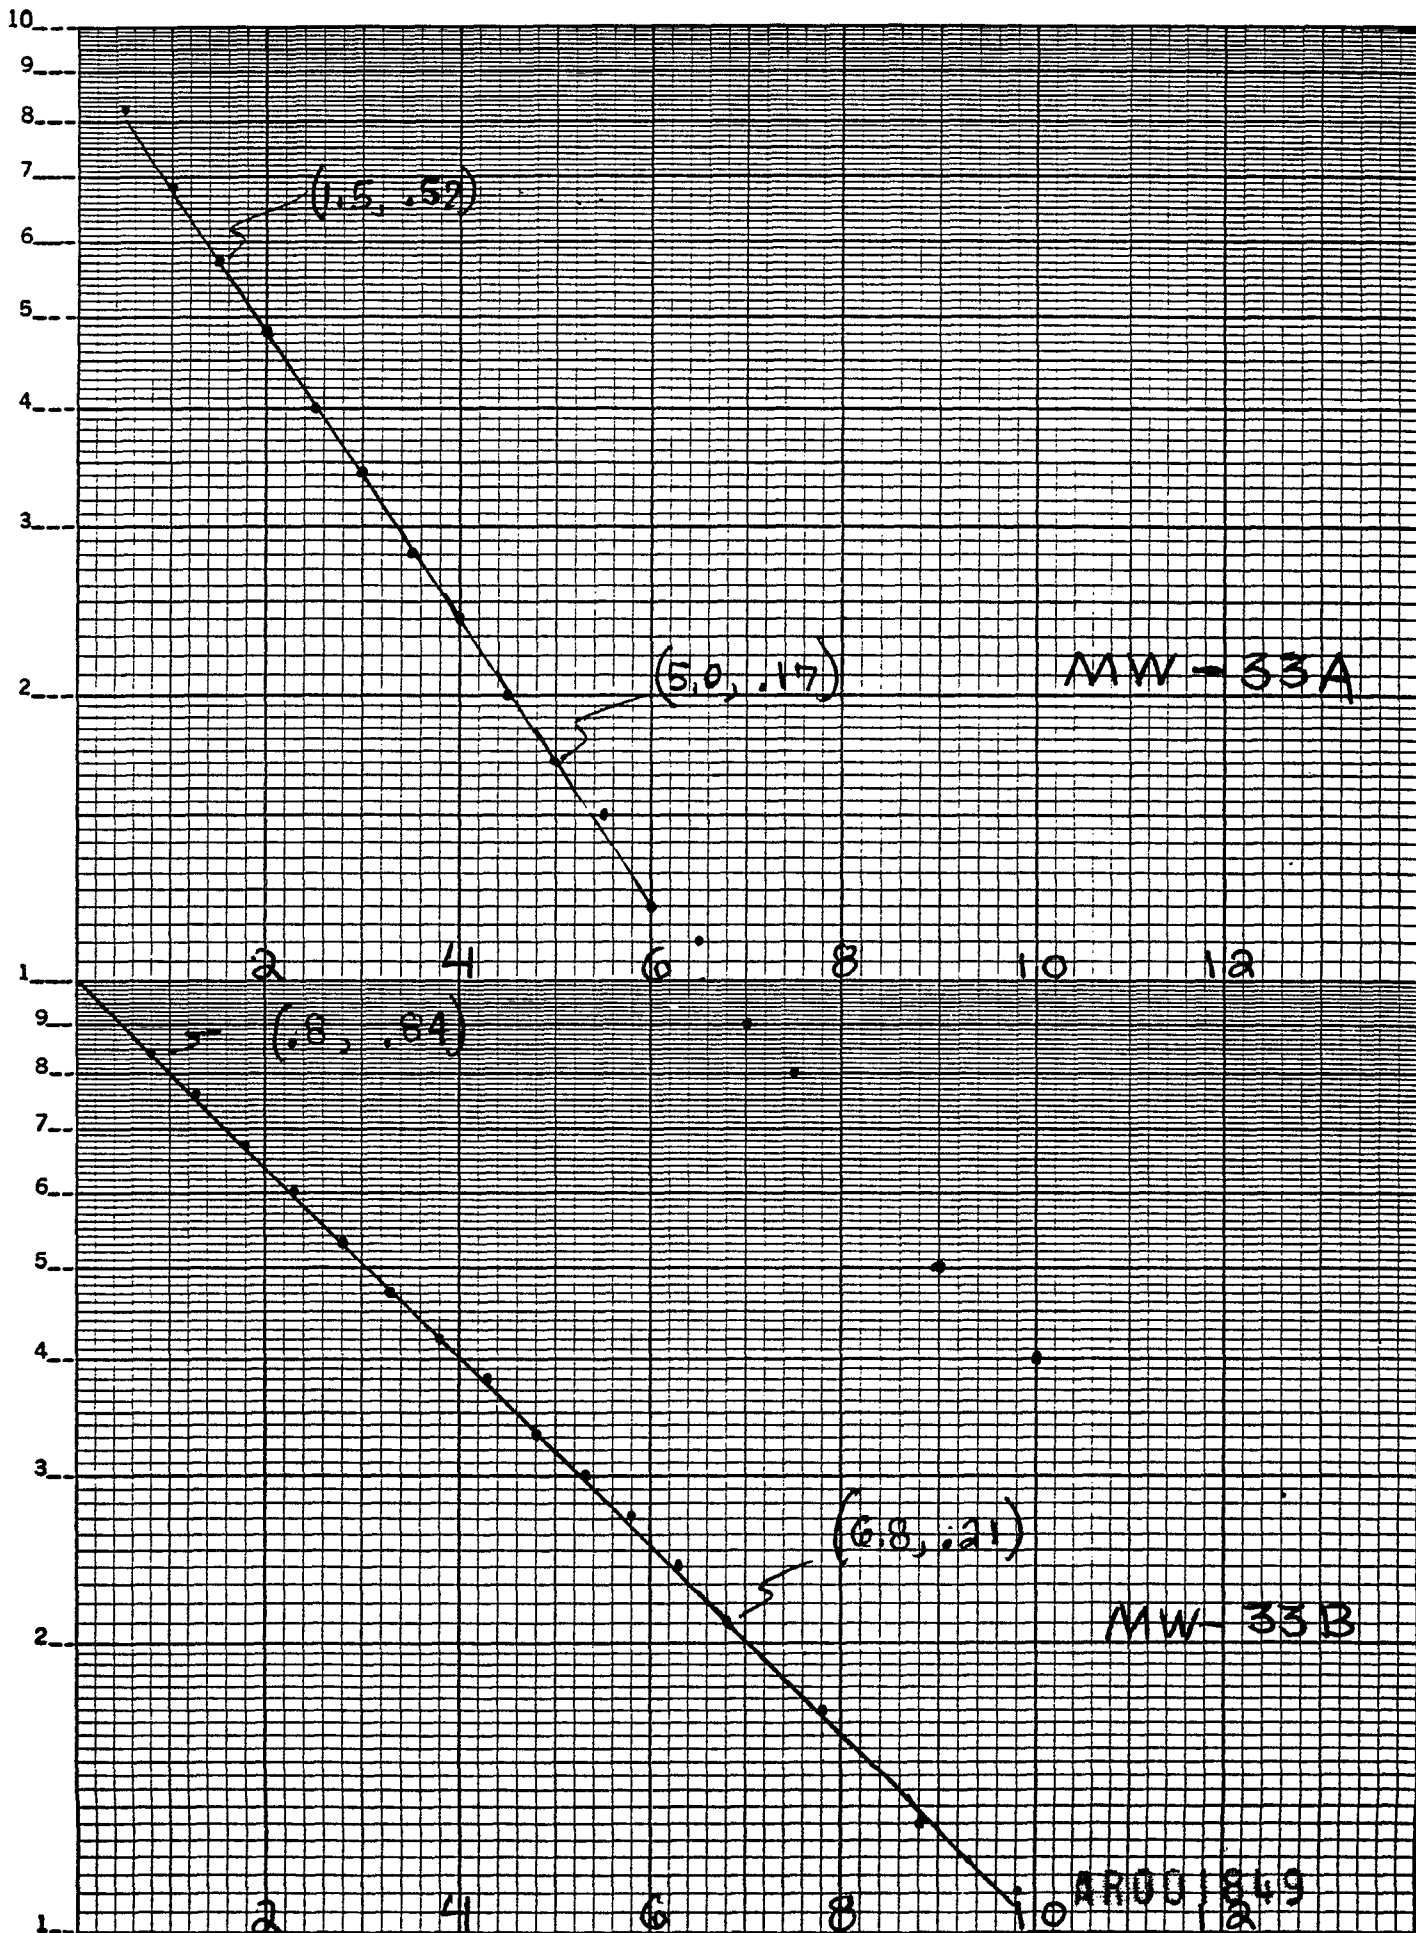

(RED)

FIELD DATA SHEET

IN-SITU HYDRAULIC CONDUCTIVITY TEST

PROJECT NUMBER AND CLIENT NAME 0285-23-1 ARMY COE		LOCATION MILLCREEK	DATE OF TEST 5/16/88	WELL NUMBER 33A	
TEST TYPE RISING HEAD	TEST METHOD (EQUIP.) BAILER		INITIAL WATER LEVEL BELOW REF. l_i (ft.) 7.90 TOC	TESTED BY: RHO	
CLOCK TIME	ELAPSED TIME (t) Units: _____	WATER LEVEL BELOW REF. AT TIME $t(l_t)$ (Ft)	HEAD AT TIME $t(h_t)$ $h_t = l_t - l_i$	HEAD RATIO h_t/h_o	REMARKS
10:01	0	13.90			
10:13:00	.50	12.80			
10:20:00	1.00	12.00			
10:23:00	1.50	11.30			
10:28:00	2.00	10.75			
10:33:00	2.50	10.30			
10:40:00	3.00	9.95			
10:43:00	3.50	9.60			
10:50:00	4.00	9.35			
10:53:00	4.50	9.10			
10:56:00	5.00	8.95			
10:56:30	5.50	8.78			
10:57:00	6.00	8.64			
10:57:30	6.50	8.55			
10:58:00	7.00	8.45			
10:58:30	7.50	8.38			
11:00:00	9.00	8.22			
11:00:00	10.00	8.15			
13:00	12.00	8.05			
15:00	14.00	7.99			
17:00	16.00	7.96			
				AR001850	

FIELD DATA SHEET

IN-SITU HYDRAULIC CONDUCTIVITY TEST

PROJECT NUMBER AND CLIENT NAME 0285-23-1 ARMY COE		LOCATION MILLCREEK	DATE OF TEST 5/16/88	WELL NUMBER 33B	
TEST TYPE RISING HEAD	TEST METHOD (EQUIP.) BAIL - 8 gal		INITIAL WATER LEVEL BELOW REF. l_i (ft.) 7.45' TOC		TESTED BY: RHO
CLOCK TIME	ELAPSED TIME (t) Units: <u>min</u>	WATER LEVEL BELOW REF. AT TIME $t(l_t)$ (Ft)	HEAD AT TIME $t(h_t)$ $h_t = l_t - l_i$	HEAD RATIO h_t/h_o	REMARKS
3:32:15	0	14.65			
32:40	.42	14.00			
33:00	.75	13.50			
33:30	1.25	12.90			
34:00	1.75	12.30			
34:30	2.25	11.77			
35:00	2.75	11.30			
35:30	3.25	10.85			
36:00	3.75	10.49			
36:30	4.25	10.16			
37:00	4.75	9.85			
37:30	5.25	9.60			
38:00	5.75	9.37			
38:30	6.25	9.15			
39:00	6.75	8.98			
40:00	7.75	8.66			
41:00	8.75	8.40			
42:00	9.75	8.21			
44:00	11.75	7.93			
46:00	13.75	7.75			
48:00	15.75	7.64			
AR001851					

MW-34 6-16-33

$$\begin{aligned} r_c &= 2 \text{ inches} = .167' \\ r_w &= 6 \text{ inches} = .5' \\ L &= 8.3' \end{aligned}$$

$$\begin{aligned} t_1 &= 4.6 \text{ sec} \quad h_1 = .85 \\ t_2 &= 49.6 \text{ sec} \quad h_2 = .25 \end{aligned}$$

.077 min
.827 min

$$K = \frac{(r_c)^2 \ln L/R_w}{2L (t_2 - t_1)} \cdot \ln \frac{h_1}{h_2}$$

$$= \frac{(.167)^2 \ln 8.3/.5}{2 (8.3) (49.6 - 4.6)} \cdot \ln \frac{.85}{.25} = .00012836 \text{ ft/sec}$$

$$\times \frac{12 \text{ in}}{\text{ft}} \times \frac{2.54 \text{ cm}}{\text{in}} = 3.9 \times 10^{-3} \text{ cm/sec} *$$

computer $3.896 \times 10^{-3} \text{ cm/sec}$

FIELD DATA SHEET
IN-SITU HYDRAULIC CONDUCTIVITY TEST

PROJECT NUMBER AND CLIENT NAME 0285-23-1 COLE		LOCATION MILLCREEK	DATE OF TEST 6-16-83	WELL NUMBER 34	
TEST TYPE RISING HEAD	TEST METHOD (EQUIP.) 2" PVC SLUG + transducer		INITIAL WATER LEVEL BELOW REF. l_i (ft.) 10.91	TESTED BY: RHO	
CLOCK TIME	ELAPSED TIME (t) Units: <u>sec</u>	WATER LEVEL BELOW REF. AT TIME $t(l_t)$ (Ft)	HEAD AT TIME $t(h_t)$ $h_t = l_t - l_i$	HEAD RATIO h_t/h_0	REMARKS
	0	13.80	2.89 ✓	1.00	
	1	13.69	2.78	.96	
	4.6	13.38	2.47	.85	
	8.6	13.11	2.20	.76	
	11.6	12.93	2.02	.70	
	14.6	12.77	1.86	.64	
	18.6	12.57	1.66	.57	
	24.6	12.32	1.41	.49	
	39.6	11.85	0.94	.33	
	49.6	11.63	0.72	.25	
	✓ 69.6	11.33	0.42 ✓	.15	
	89.6	11.15	0.24	.08	
	119.6	11.02	0.11	.04	
	149.6	10.96			
	179.6	10.94			
				AR00	853

ORIGINAL (RED)

AW-34
6-16-88

AQUABEE
MADE IN USA

DRAWING PAPER NO. 1371-21
TRACING PAPER NO. 1230-21
SEMI-LOG. 3 CY. BY 10 DIV. / IN.

$\ln y$


$\ln \frac{h_0}{h_t}$

1.0

0.10

ELAPSED TIME (SEC)

AR001854

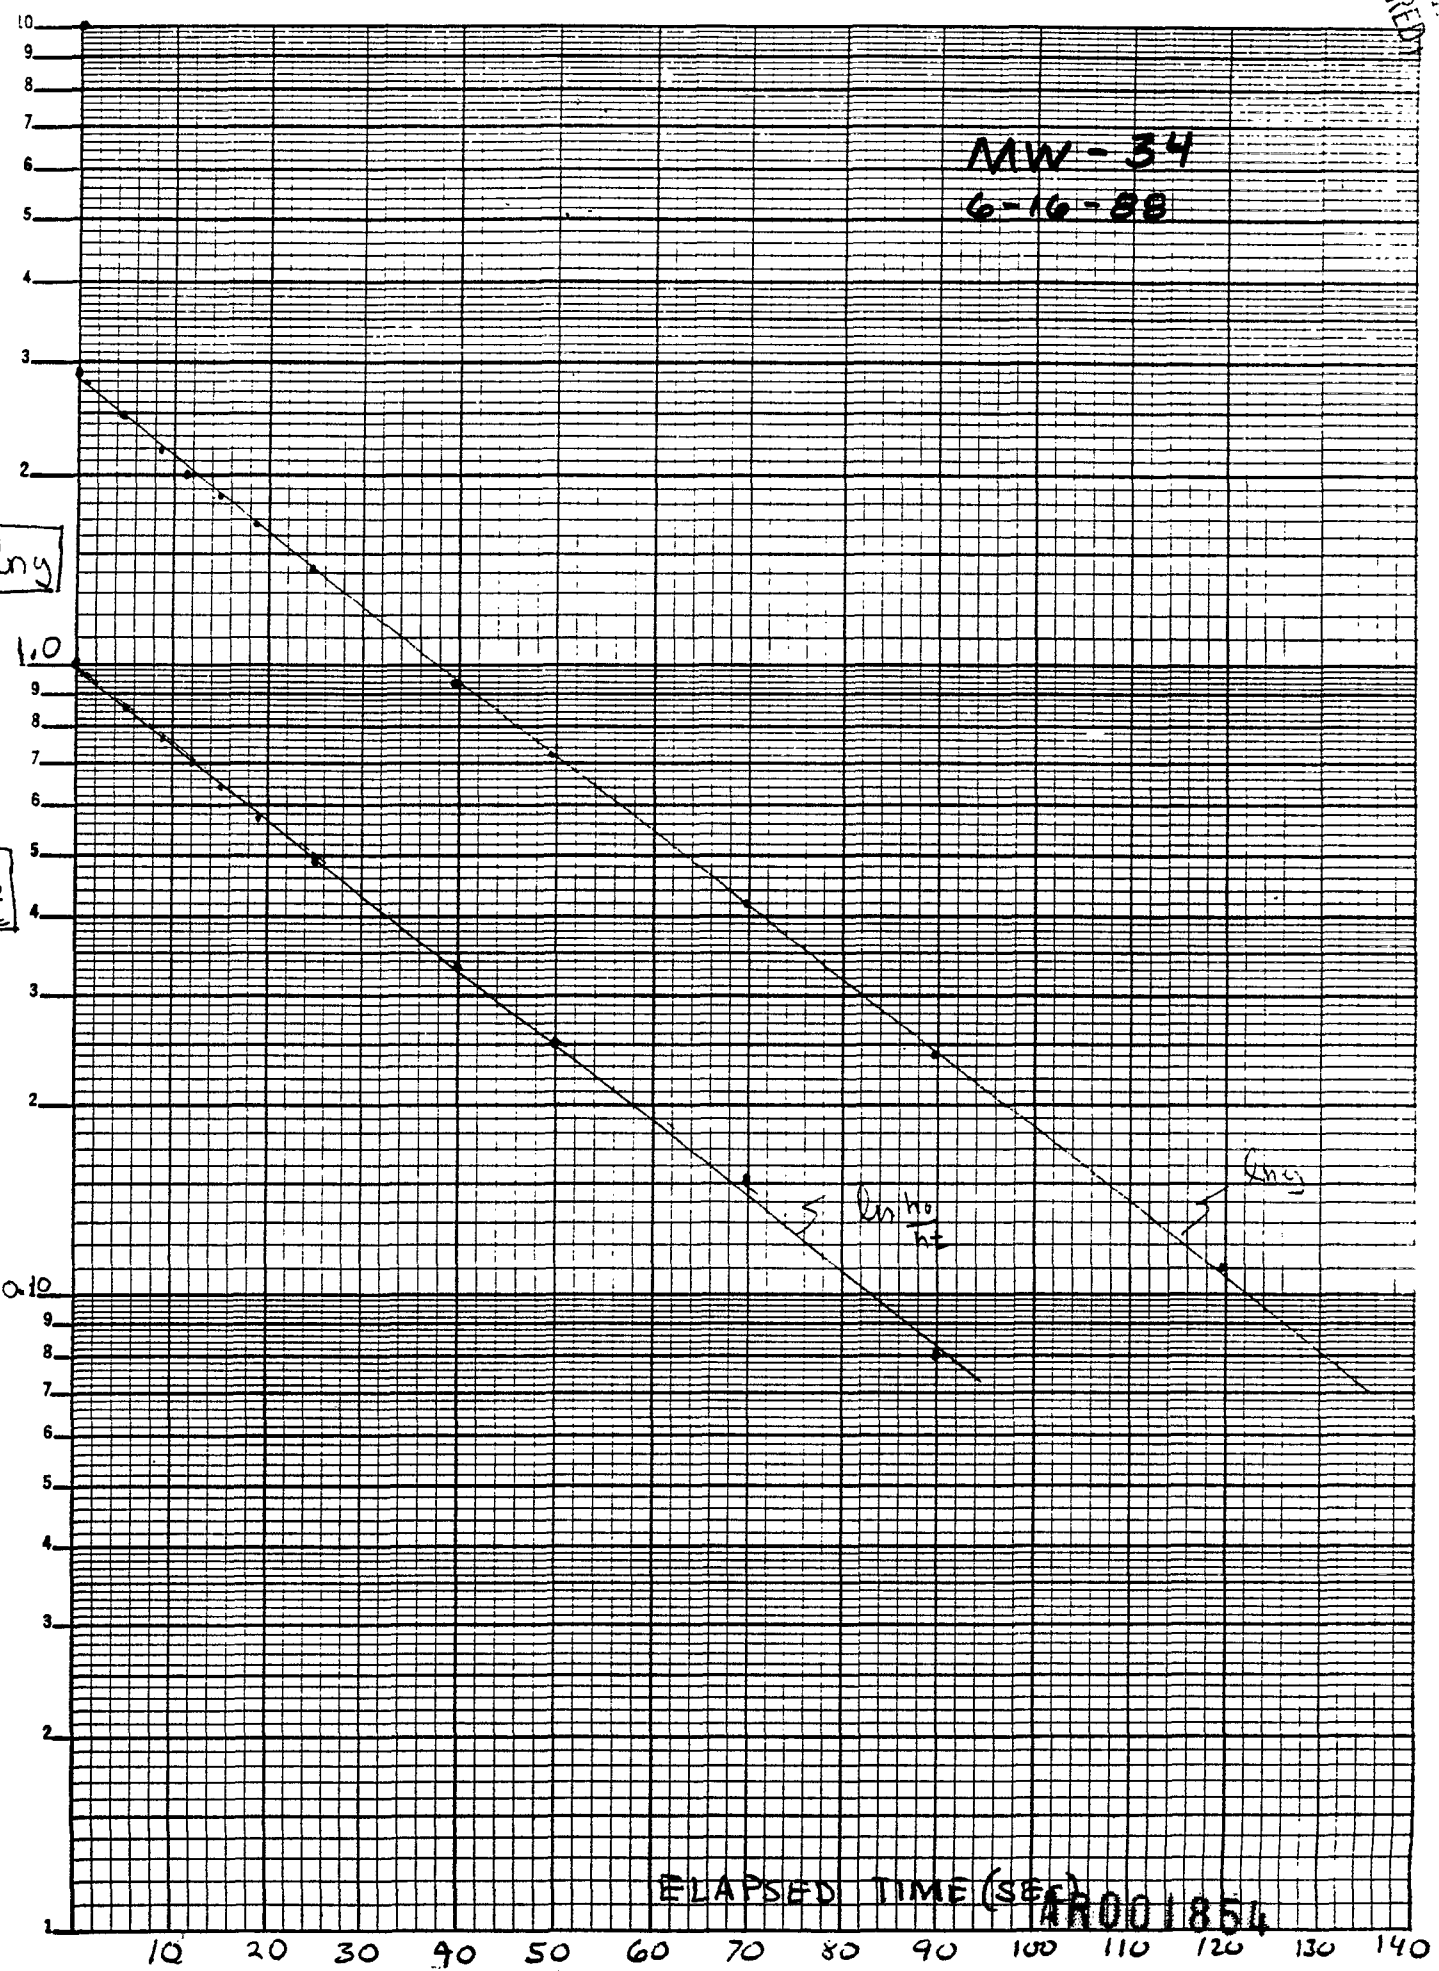

MW - 34

$$\begin{aligned}
 H &= 17.55 + 2.27 - 10.91 = 8.91 & D > H \\
 D &= 19.0 + 2.27 - 10.91 = 10.36 \\
 r_w &= 6 \text{ in} & & = .5' & -/r_w = 13.70 \\
 L &= 17.55 - 10.70 & & = 6.85' \\
 r_c &= 2 \text{ in} & & = .167' & A = 1.95 \\
 t &= & & = 69.6 \text{ sec} & B = 1.25 \\
 y_o &= & & = 2.89 \\
 y_t &= & & = 0.42
 \end{aligned}$$

$$\begin{aligned}
 \ln(R_e/r_w) &= \left(\frac{1.1}{\ln H/r_w} + \frac{A + B \ln(z-H)/r_w}{L/r_w} \right) \\
 &= \frac{1.1}{2.8803} + \frac{1.95 + 1.25(1.0647)}{13.70} \\
 &= (0.3819 + 0.2395)^{-1} = 1.6093.
 \end{aligned}$$

$$\begin{aligned}
 K &= \frac{r_c^2 \ln(R_e/r_w)}{2L} \cdot \frac{1}{t} \ln \frac{y_o}{y_t} \\
 &= \frac{(.167)^2 (1.6093)}{2 (6.85)} \cdot \frac{1}{69.6 \text{ sec}} \ln \frac{2.89}{.42} = .00009079 \text{ ft/sec}
 \end{aligned}$$

$$= \times \frac{12 \text{ in}}{\text{ft}} \times \frac{2.54 \text{ cm}}{\text{in}} = \frac{2.8 \times 10^{-3} \text{ cm/sec}}{2.76 \times 10^{-3}}$$


MW-35

$$D = \text{ELEV(WATER LEVEL)} - \text{ELEV.(BASE OF AQUIFER)} \\ = 21.0 - .40 - 5.15 = 15.45'$$

$$H = \text{ELEV(WATER LEVEL)} - \text{ELEV(BASE OF WELL)} \\ = 13.90 - .40 - 5.15 = 8.35'$$

$$r_w = \text{BOREHOLE } \phi = 0.5'$$

$$L = \text{SCREEN LENGTH (OR SATURATED SCREENED INTERVAL IF SMALLER)} \\ = 13.9 - 7.0 = 6.9'$$

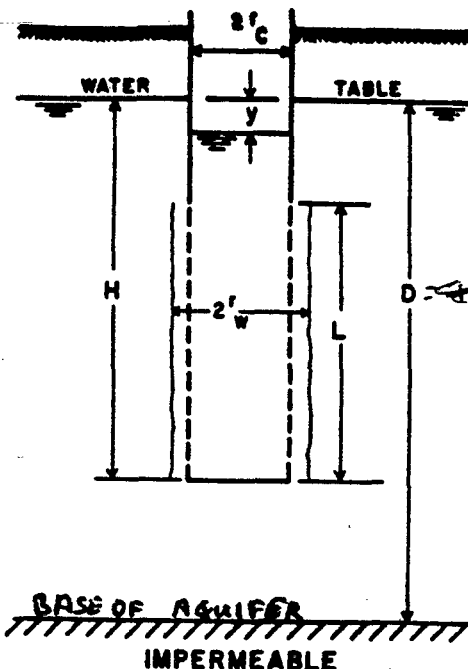

$$r_c = \text{WELL } \phi = .167'$$

$$y_0 = \text{INITIAL DRAWDOWN} = 2.5'$$

$$y_t = \text{DRAWDOWN AT TIME (t)} = .54$$

$$t = \text{TIME t (sec)} = 22$$

$$L/r_w = 13.80$$

$$A = 2.0$$

$$B = 1.30$$

$$C =$$

$$\ln \frac{R_e}{r_w} = \left[\frac{1.1}{\ln H/r_w} + \frac{A + B \ln[(D-H)/r_w]}{L/r_w} \right]^{-1} =$$

$$= \left[\frac{1.1}{2.8154} + \frac{2.0 + 1.30 (2.6532)}{13.80} \right]^{-1} = (0.3907 + 0.3949)^{-1} = 1.273$$

$$\ln \frac{R_e}{r_w} = \left(\frac{1.1}{\ln H/r_w} + \frac{C}{L/r_w} \right)^{-1}$$

$$K = \frac{r_c^2 \ln(R_e/r_w)}{2L} \left(\frac{1}{t} \right) \ln \frac{y_0}{y_t} = \frac{(.167)^2 (1.273)}{13.80 (6.90)} \cdot \frac{1}{22 \text{ sec}} \cdot \ln \frac{2.5}{.54}$$

$$= 1.792 \times 10^{-4} \frac{\text{ft}}{\text{sec}} \times \frac{12 \text{ in}}{\text{ft}} \times \frac{2.54 \text{ cm}}{\text{in}} = 5.5 \times 10^{-3} \text{ cm/sec}$$

5.4 AR001856

FIELD DATA SHEET

IN-SITU HYDRAULIC CONDUCTIVITY TEST

PROJECT NUMBER AND CLIENT NAME 0285-22-1 COE		LOCATION MILLCREEK	DATE OF TEST 6-17-88	WELL NUMBER 35	
TEST TYPE RISING HEAD	TEST METHOD (EQUIP.) 2" PVC SLUG Transducer		INITIAL WATER LEVEL BELOW REF. l_i (ft.) 5.15	TESTED BY: RHO	
CLOCK TIME	ELAPSED TIME (t) Units: <u>Sec</u>	WATER LEVEL BELOW REF. AT TIME $t(l_t)$ (Ft)	HEAD AT TIME $t(h_t)$ $h_t = l_t - l_i$	HEAD RATIO h_t/h_o	REMARKS
	0	7.86	2.71	1.0	
	.2	7.56	2.41	.89	
	.4	7.49	2.34	.86	
	.6	7.32	2.17	.80	
	2.2	7.18	2.03	.75	
	4.2	6.94			
	6.2	6.74	1.59	.59	
	8.2	6.55	1.40	.52	
	10.2	6.40	1.25	.46	
	12.2	6.25		.41	
	14.2	6.11	0.96	.35	
	16.2	5.99	.84	.31	
	18.2	5.88	0.73	.27	
	24.2	5.60	.45	.17	
	29.2	5.42	0.27	.10	
	34.2	5.28		.05	
	39.2	5.18	0.03		

AR001857

ORIGINAL
(RED)

MW-35
6-17-88

$\ln h_0/h_t$


AQUABEE
MADE IN USA

DRAWING PAPER NO. 1971-21
TRACING PAPER NO. 1230-21
SEMI-LOG. 3 CY. BY 10 DIV./ IN.

$\ln y$

ELAPSED TIME (SEC)

AR001858

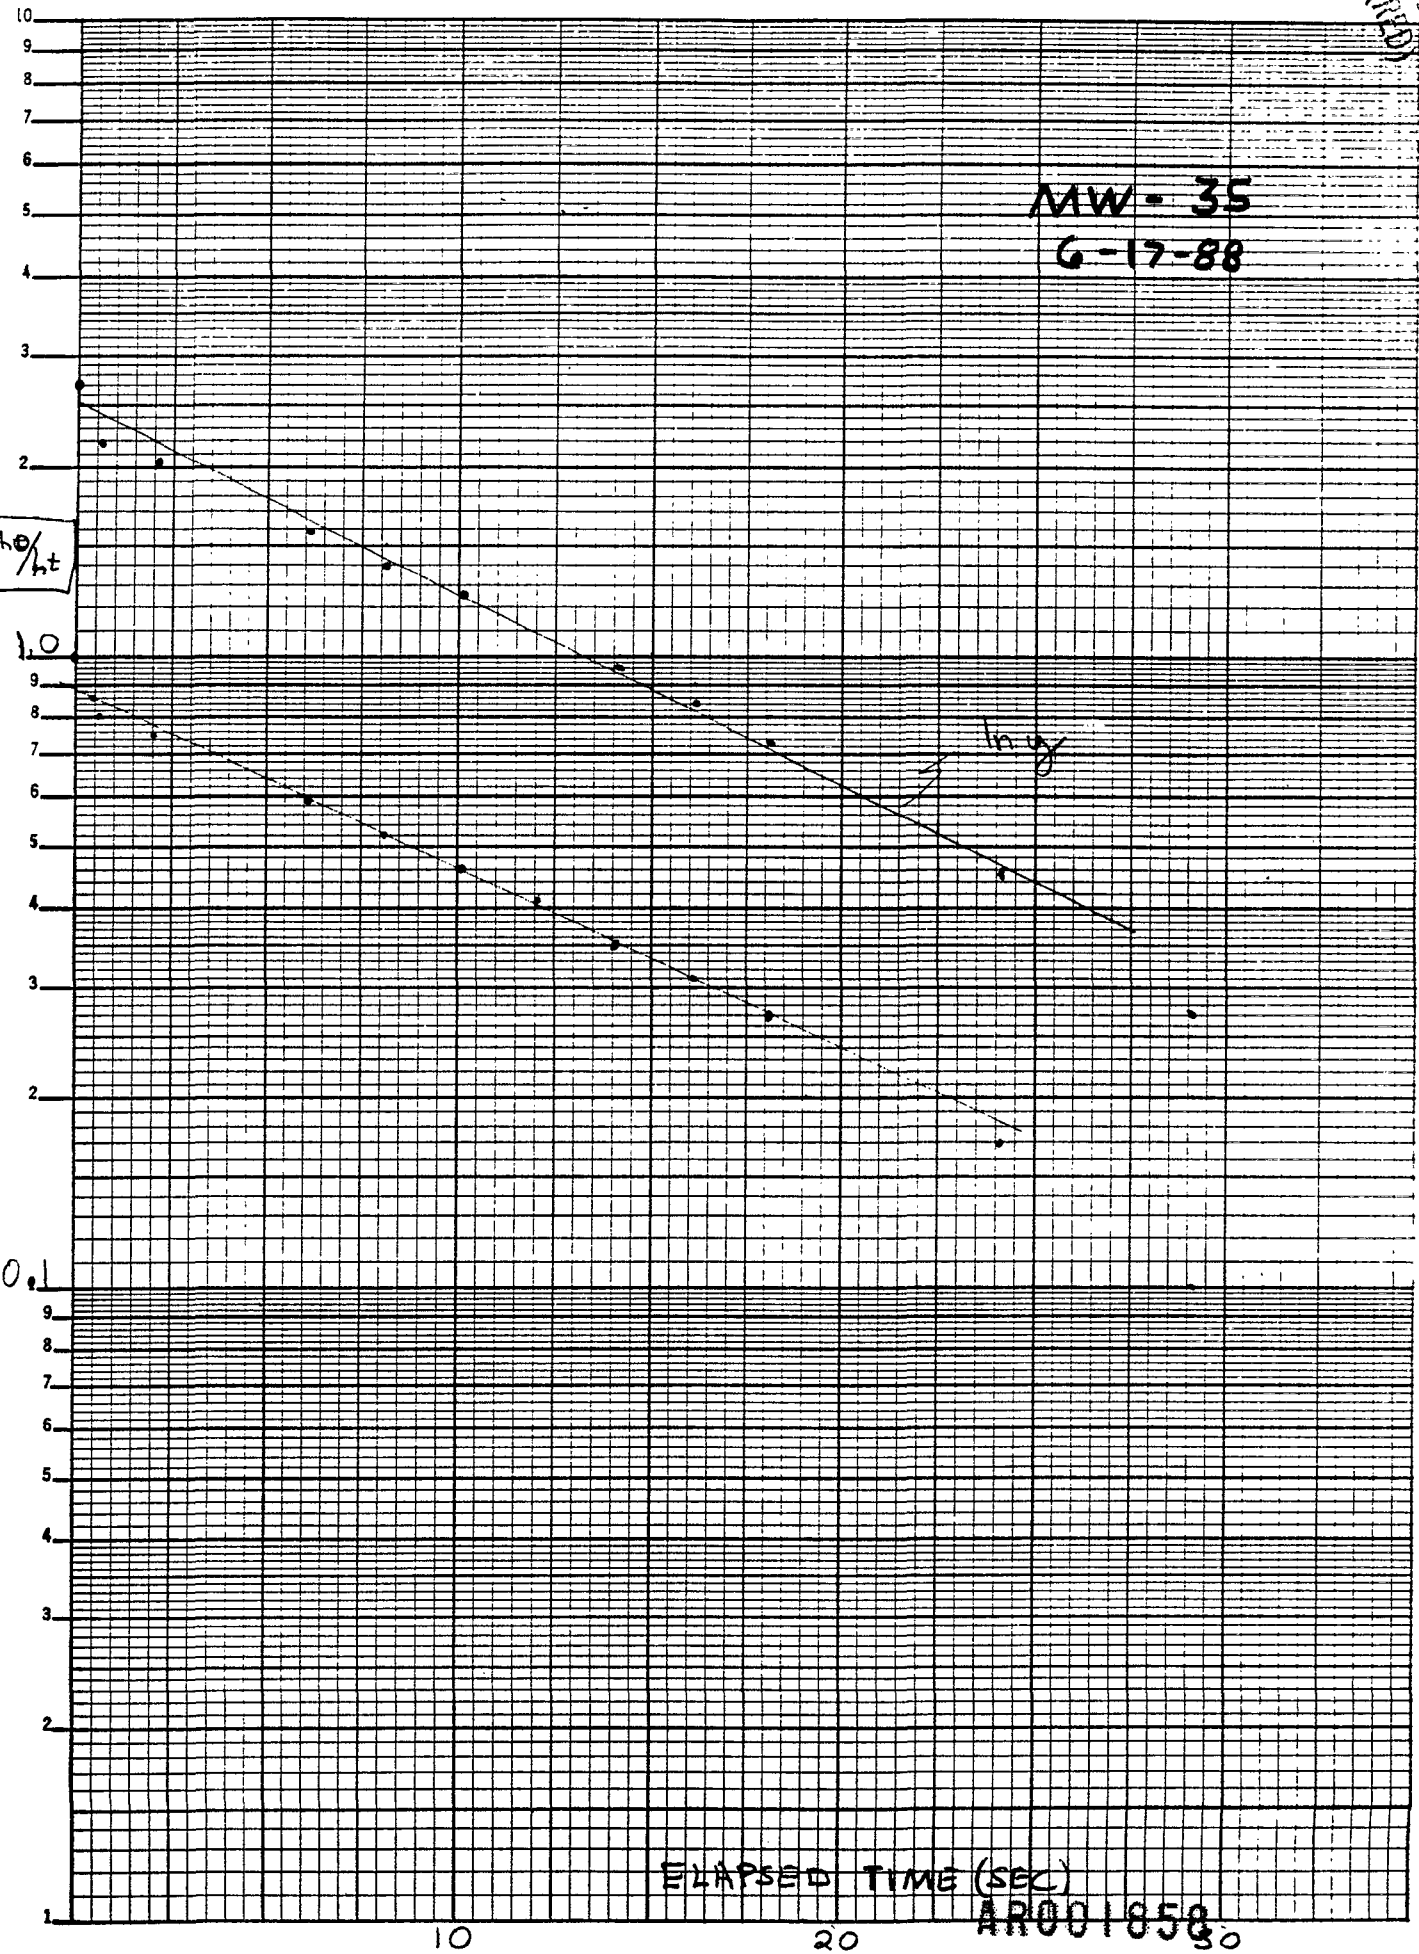

MW - 35

6-17-88

Hvorner

$$r_c = 2' = .67'$$

$$R = 6' = .5'$$

$$\text{Sand Pack length } (L) = 6.9'$$

$$t_1 = 5 \text{ sec} \quad H_1 = .64$$

$$t_2 = 20 \text{ sec} \quad H_2 = .24$$

$$K = \frac{(r_c)^2 \ln(L/r_w)}{2L(t_2 - t_1)} \cdot \ln \frac{H_1}{H_2}$$

$$= \frac{(.67)^2 \ln(6.9/.5)}{2(6.9)(20-5)} \cdot \ln \frac{.64}{.24} = .0003468 \text{ ft/sec}$$

$$\times \frac{12 \text{ in}}{\text{ft}} \times \frac{254 \text{ cm}}{\text{in}} = 1.1 \times 10^{-2} \text{ cm/sec}$$

Reasonable for gravels as logged
but no major evidence of
confined conditions.
so used Bouwer & Rice

OK